

1" = 50'

Lot 128
Hawthorne

N/E LYNCH
RACHEL R. PAGE 7681
D.B. 675 PAGE 29-2481
PIN# 1813.00-29

HOWARD A. KEARNEY
DALIA R. PAGE 791
D.B. 216 PAGE 29-4579
PIN# 1813.00-29

NOTICE TO APPLICANT AND HEALTH/INSPECTION DEPTS.
Any changes made to this drawing/ plat or to the physical siting of
the structure or use herein permitted without written approval
the Granville County Planning Department shall render
Permit void and subject to legal action per Section
the Granville County Zoning Ordinance.

Supply
line no less
than 5' to
property line


* Keep pressure main
as far from well
location as feasible

127

ULLETTE
COURT
PUBLIC

EAST BAY COURT 50' PUBLIC R/W

THIS SUR
WARREN
OF AR
THEY
THE

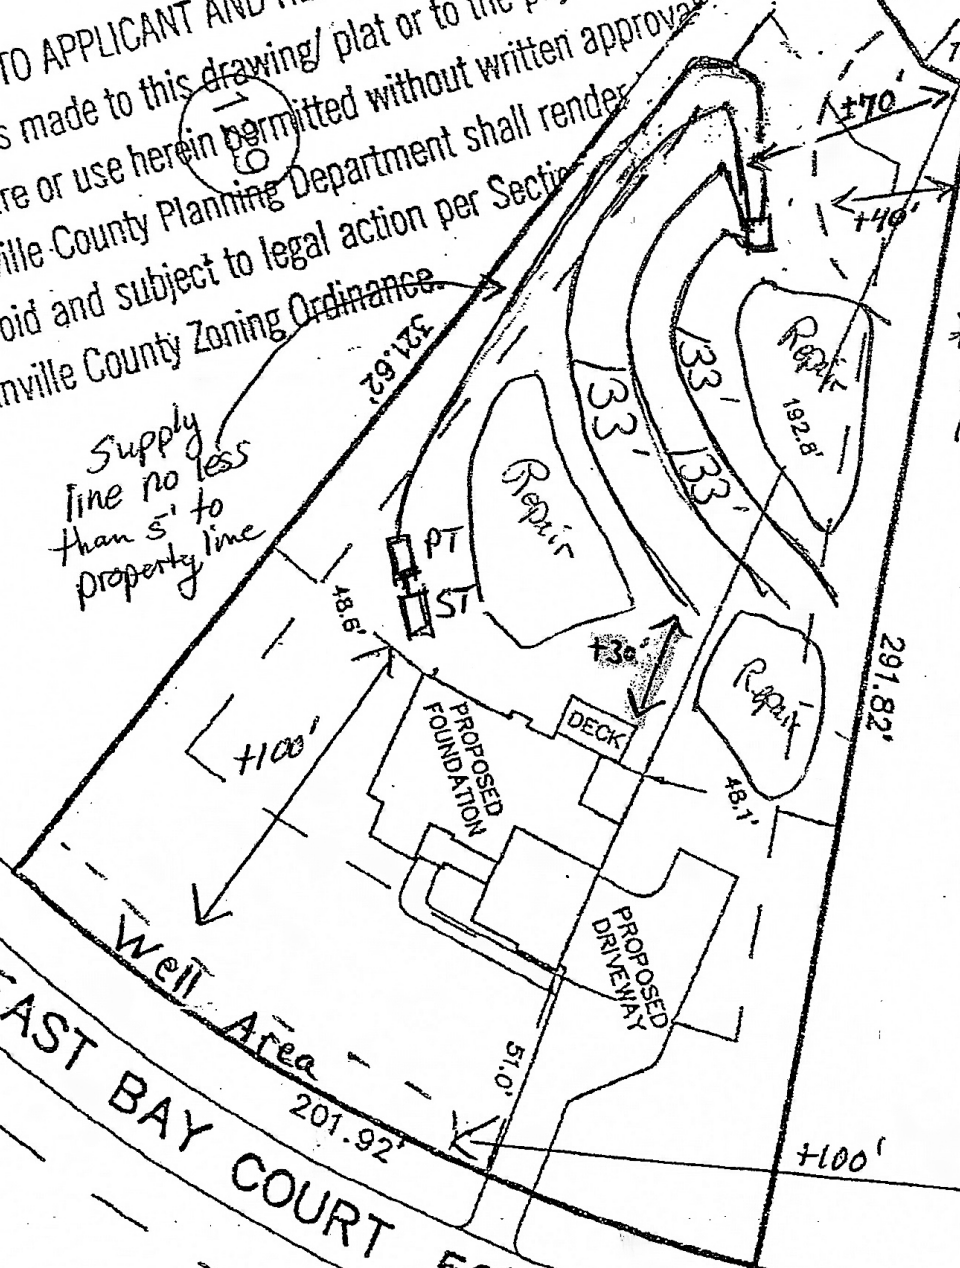

GRANVILLE-VANCE DISTRICT HEALTH DEPARTMENT

16824

IMPROVEMENT AND OPERATION PERMITS

COUNTY:	TAX NO.	TYPE OF ESTABLISHMENTS			*THIS PERMIT SHALL BE ACCOMPANIED BY A LAYOUT SHOWN ON A PLAT, INCLUDING SYSTEM REQUIREMENTS.
Granville	181300296178	RESIDENCE ☒	NUMBER OF BEDROOMS:	NUMBER OF OCCUPANTS:	
OWNER:	SR. NO.	BUSINESS ☐	4	8 max.	
OWNER: Sumner Const.		OTHER ☐			
APPLICANT'S ADDRESS:		WATER SUPPLY	WELL ☒	OTHER ☐	*THIS IMPROVEMENT PERMIT IS SUBJECT TO REVOCATION IF THE INTENDED USES CHANGE FROM THOSE SHOWN ON THE IMPROVEMENT PERMIT. CHANGES SHALL REQUIRE HEALTH DEPARTMENT APPROVAL.
P.O. Box 1011		TYPE OF WASTEWATER SYSTEM	INITIAL INSTALLATION	REPAIR	
PROPERTY ADDRESS/LOCATION:		DESIGN FLOW:	1480 gpd		
East Bay Court		LTAR:	3 gpd/ft ²		
SUBDIVISION:		ABSORPTION AREA:	1600 ft ²		PERMIT VALID FOR: 5 YEARS ☒ YES ☐ NO
Hawthorne		TRENCH WIDTH:	3'		
LOT NUMBER: 128		TRENCH DEPTH:	24"		
REFERENCE SKETCH (SEE PLAT FOR DETAILS)		TRENCH SPACING:	9' O.C.		
- Dig lines level and on contour - Keep lines close to 9' on center to allow repair room - Pay attention to well location on adjacent lot		TOTAL TRENCH LENGTH:	400'		NO EXPIRATION YES ☒ NO ☐
		NUMBER OF TRENCHES:	3		
		GRAVEL DEPTH:	Acceptable Status		
		TANK SIZE:	1200 gal		
		PUMP TANK SIZE:	1200 gal		
	DISTRIBUTION DEVICE:	Press. free manifold			

IMPROVEMENT PERMIT

DATE:

FOR:

Sumner Construction

12-28-10

ISSUED BY:

David Pumber

CONSTRUCTION AUTHORIZATION FOR IMPROVEMENT PERMIT# 6974

Unless otherwise indicated, the same conditions above apply regarding system type, layout, location and installation requirements.

(The wastewater system cannot be installed until authorization is signed)

Comments:

Call 693-2058 w/ permit to install system

Date: 12-28-10 Environmental Health Specialist:

David Pumber

Construction Authorization Addendum ☐ Yes ☒ No

OPERATION PERMIT

DATE: 6-16-11

SYSTEM INSTALLED BY:

Trench

ISSUED BY:

David Pumber

plup/pm- 8-23-11

PERFORMANCE MONITORING, MAINTENANCE AND OPERATION

take some his, gup was REQUIRED BY RULE .1961