

GRANVILLE-VANCE DISTRICT HEALTH DEPARTMENT IMPROVEMENT AND OPERATION PERMITS

COUNTY:	TAX NO.	TYPE OF ESTABLISHMENTS			*THIS PERMIT SHALL BE ACCOMPANIED BY A LAYOUT SHOWN ON A PLAT, INCLUDING SYSTEM REQUIREMENTS.
Granville	182500437121	RESIDENCE ☒	NUMBER OF BEDROOMS:	NUMBER OF OCCUPANTS:	
	SR. NO.	BUSINESS ☐	4	8 MAX	
	OTHER ☐	WATER SUPPLY	WELL ☐	OTHER ☐	
APPLICANT:	Wynn Construction	TYPE OF WASTEWATER SYSTEM	INITIAL INSTALLATION	REPAIR	*THIS IMPROVEMENT PERMIT IS SUBJECT TO REVOCATION IF THE INTENDED USES CHANGE FROM THOSE SHOWN ON THE IMPROVEMENT PERMIT. CHANGES SHALL REQUIRE HEALTH DEPARTMENT APPROVAL.
APPLICANT'S NAME & ADDRESS:		DESIGN FLOW:			
PROPERTY ADDRESS/LOCATION:	Red Bud Court	LTAR:			
SUBDIVISION:	New Forest IV	ABSORPTION AREA:			
LOT NUMBER:	115	TRENCH WIDTH:			
REFERENCE SKETCH (SEE PLAT FOR DETAILS)		TRENCH DEPTH:			
		TRENCH SPACING:			
		TOTAL TRENCH LENGTH:			
		NUMBER OF TRENCHES:			
		GRAVEL DEPTH:			
		TANK SIZE:			PERMIT VALID FOR: 5 YEARS YES ☒ NO ☐
		PUMP TANK SIZE:			
		DISTRIBUTION DEVICE:			NO EXPIRATION YES ☐ NO ☒

* Risers on tanks
 * lay use serial distribution
 * Follow soil scientist layout

 IMPROVEMENT PERMIT DATE: 11-17-17
 FOR: Wynn Construction
 ISSUED BY: Adam Curran

CONSTRUCTION AUTHORIZATION FOR IMPROVEMENT PERMIT# 9229

Unless otherwise indicated, the same conditions above apply regarding system type, layout, location and installation requirements.
 (The wastewater system cannot be installed until authorization is signed)

Comments:

Date: 11-17-17 Environmental Health Specialist: Adam Curran
 Construction Authorization Addendum ☒ Yes ☐ No

 OPERATION PERMIT DATE: TANK (3-19-18) WTC
 SYSTEM INSTALLED BY: Blackley Lines (3-23-18) AWC
 ISSUED BY: Adam Curran Pump 4-13-18
 PERFORMANCE, MONITORING, MAINTENANCE AND OPERATION
 AS REQUIRED BY RULE .1961

**Granville – Vance District Health Department
Environmental Health**

Final Sketch

Pin _____

____ Improvement Permit

____ Construction Authorization

Wynn const.
Applicant's Name

Permit No. 9229


New forest IV 115
Subdivision – Section – Lot

Physical Address: Red bud ct.

Blackley
System Installer

Date

System design and details as installed.

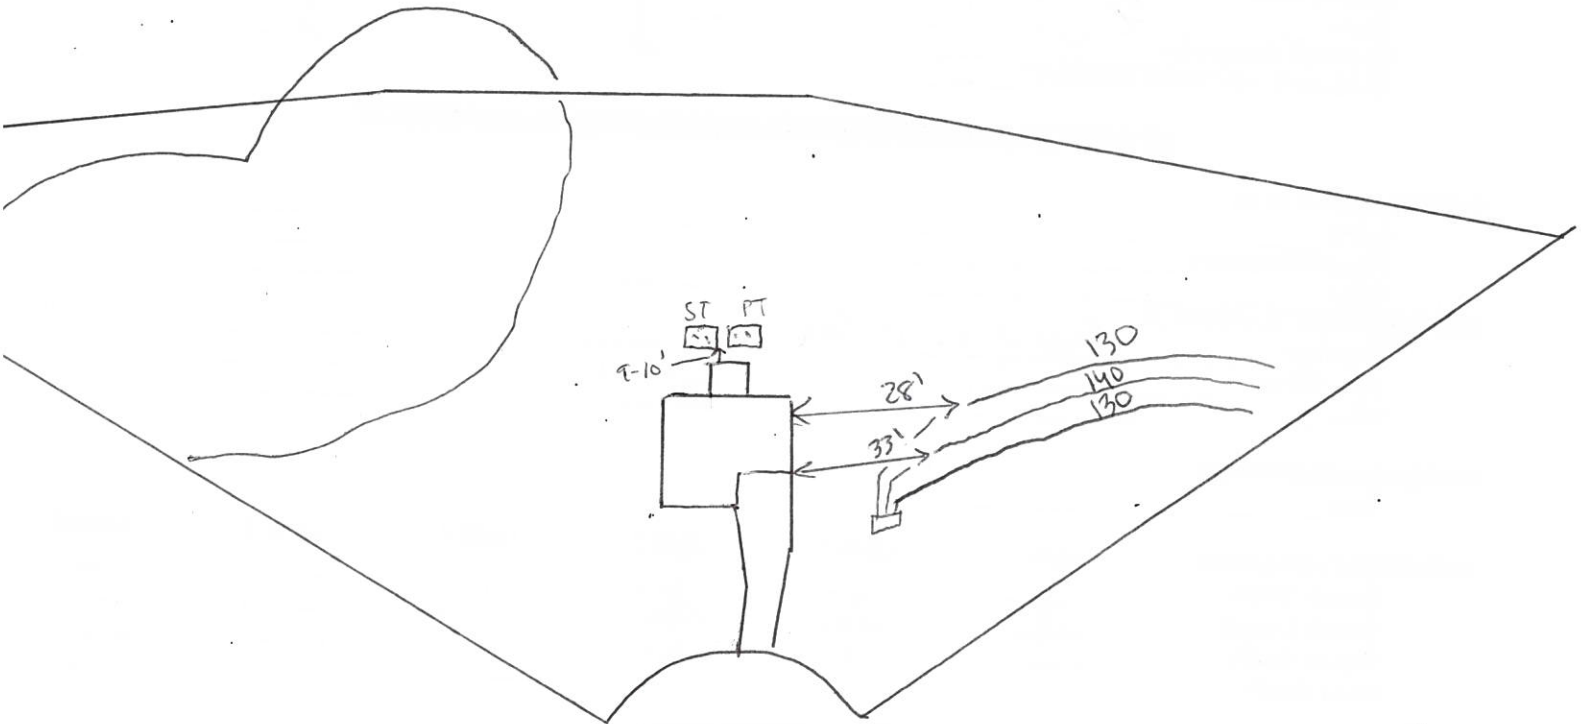

Robert Currier
Authorized Signature

4/24/18
Date