

PERMIT NUMBER 07168

GRANVILLE-VANCE DISTRICT HEALTH DEPARTMENT IMPROVEMENT AND OPERATION PERMITS

2P 17312

COUNTY: <u>Granville</u>	TAX NO. <u>101164542607</u>	TYPE OF ESTABLISHMENTS			*THIS PERMIT SHALL BE ACCOMPANIED BY A LAYOUT SHOWN ON A PLAT, INCLUDING SYSTEM REQUIREMENTS.
	SR. NO.	RESIDENCE ☒ BUSINESS ☐ OTHER ☐	NUMBER OF BEDROOMS: <u>3</u>	NUMBER OF OCCUPANTS: <u>max 6</u>	
OWNER: <u>Michael + Shelby Waller</u>		WATER SUPPLY	WELL ☒ PUBLIC ☐	OTHER ☐	*THIS IMPROVEMENT PERMIT IS SUBJECT TO REVOCATION IF THE INTENDED USES CHANGE FROM THOSE SHOWN ON THE IMPROVEMENT PERMIT. CHANGES SHALL REQUIRE HEALTH DEPARTMENT APPROVAL.
APPLICANT'S ADDRESS: <u>Michael Overby</u> <u>6000 White House Rd</u> <u>Nelson, VA 21580</u>		TYPE OF WASTEWATER SYSTEM	INITIAL INSTALLATION <u>IIIg</u>	REPAIR <u>IIIg</u>	
PROPERTY ADDRESS/LOCATION: <u>Lakeside Terrace</u>		DESIGN FLOW:	<u>360</u>		
SUBDIVISION: <u>Jonathan Loring</u>		LTAR:	<u>.30</u>		
LOT NUMBER: <u>lot # 7</u>		ABSORPTION AREA:	<u>1200 Ft²</u>		
REFERENCE SKETCH (SEE PLAT FOR DETAILS)		TRENCH WIDTH:	<u>36"</u>		
<u>Follow site sketch</u> <u>Call Env. Health</u> <u>with any questions</u> <u>or concerns</u>		TRENCH DEPTH:	<u>18"</u>		
		TRENCH SPACING:	<u>9' on center</u>		
		TOTAL TRENCH LENGTH:	<u>300 ft</u>		
		NUMBER OF TRENCHES:	<u>4 -</u>		
		GRAVEL DEPTH:	<u>Accepted</u>		
		TANK SIZE:	<u>1000</u>		
		PUMP TANK SIZE:	<u>N/A</u>		PERMIT VALID FOR: 5 YEARS ☒ YES ☐ NO
		DISTRIBUTION DEVICE:	<u>Distribution Box</u>		NO EXPIRATION ☐ YES ☒ NO

IMPROVEMENT PERMIT

DATE: 1-9-12

FOR: Michael + Shelby Waller

ISSUED BY: Carol Chapin

CONSTRUCTION AUTHORIZATION FOR IMPROVEMENT PERMIT#

Unless otherwise indicated, the same conditions above apply regarding system type, layout, location and installation requirements.
(The wastewater system cannot be installed until authorization is signed)

Comments: _____

Date: 1-9-12 Environmental Health Specialist: Carol Chapin
Construction Authorization Addendum ☐ Yes ☐ No

OPERATION PERMIT

DATE: 2-2-12

SYSTEM INSTALLED BY: Overby Septic

ISSUED BY: Carol Chapin

PERFORMANCE, MONITORING, MAINTENANCE AND OPERATION
AS REQUIRED BY RULE .1961

Granville – Vance District Health Department
Environmental Health

Pin _____

Permit Number 7168

☒ Improvement Permit

☒ Construction Authorization

Final Sketch

Michael Overby / Michael + Shelby
Applicants Name Walters

Sonathon's Landing Lot # 7
Subdivision – Section – Lot

Physical Address: Lakeside Terrace

Michael Overby
System Installer

2-2-12
Date

System design and details as installed.

Septic Tank Information:

Date: _____

Manufacture: PTS-1000

ID #: STB-1412

Pump Tank Information:

Date: _____

Manufacturer: _____

ID #: _____

Distribution Box ☒


Pressure Manifold _____

Serial Distribution _____

Type of Facility: Residence

Number of Bedrooms: 3

Type of System: Infiltrator

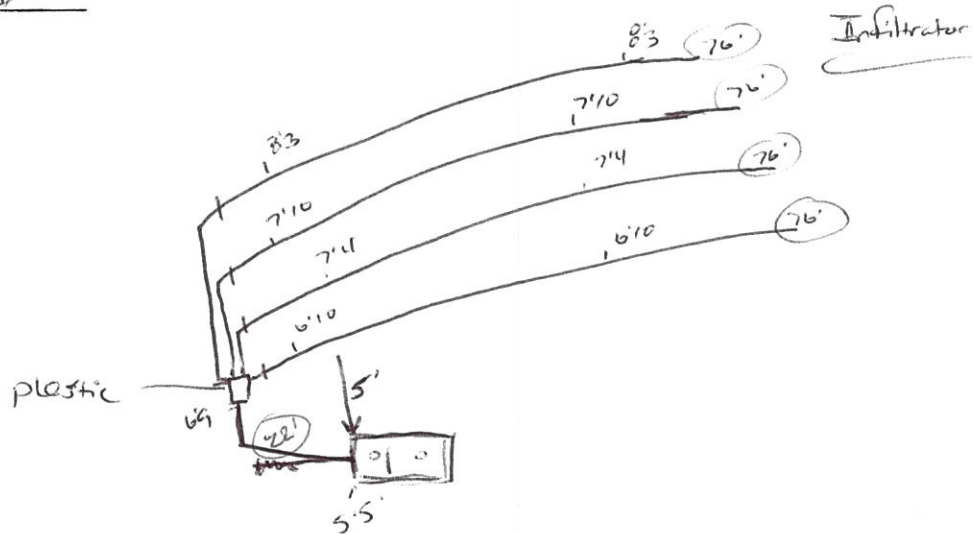

No house or well on-site

Carol Q. Chapp
Authorized Signature

2-2-12
Date

