

Granville - Vance District Health Department

Environmental Health

Well Construction Permit

00674


Owner/Applicant: Michael & Shelby Walker Date: 1-9-12
 Address or Location of Property: Grassy Cr - Virginia Rd → cross bridge on Dave
Winston Rd → (R) into Turnthams landing → (R) on Lakeside Terrace
 Subdivision & Lot #: Turnthams landing - lot # 7 Septic Permit #: 7168
 Zoning Permit #: 17312 Environmental Health Specialist: Champion

This well permit is to locate and site the area that a private groundwater well may be established on the property listed above by the Environmental Health Specialists of Granville-County. If one does not locate the well in the approved area and complete the well as specified by the 15A NCAC .02C rules, then permits may be revoked. At completion of drilling of the well, grout must be witnessed by EHS and a well log turned into Environmental Health.

Minimum Setbacks: (these are the main setbacks, but not all required setbacks)

Setback from property lines – 10 ft Setback from septic tank and drain field, including repair area – 100 ft
 Setback from structural foundations – 25 ft Setback from ponds, lakes or other bodies of water – 50 ft

Site Sketch:

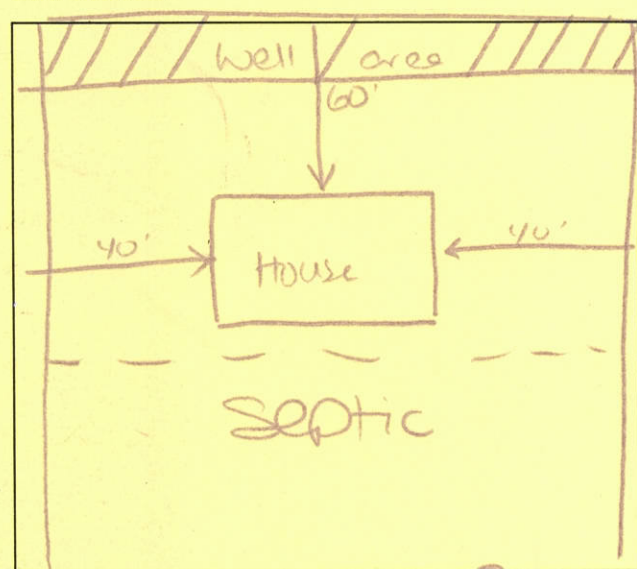

Conditions:

Authorized Agent: Carl Champion

Date: 1-9-12

1 Well Grout: (Circle or write in)

Witnessed: Yes or No EHS Agent: Champion
 Date: 6-27-12 Annular Space Open: Yes or No
 Over reamed: Yes or No Depth Grouted: 20' +
 Method: ✓ Pump Poured Pressure
 Well Log received: Yes or No (EHS to Attach to Permit)
 Driller Name: Hensley Cert. #
 Depth: 250' Casing Depth: 90' GPM: 20

2 Well Final: (Place a check mark when finalized)

Seal Present and Intact: Air Vent:
 Hose Spigot: Electrical Box:
 Pump Installer Tag: Well Installer Tag:
 All holes sealed: 12" above grade:

Comments:

3 Well Completion Permit: EHS

Date Completed:

4 Water Samples Taken: Date:

EHS: Results:

Retest: Results:

As Built Drawing:

