

GRANVILLE-VANCE HEALTH DEPARTMENT—Sewage Disposal Record

Owner or Contractor Louisburg Hardware / Mobil Mart Date 9-28-00 S.R. No. 1138

Location/Address 4082 Culbreth Rd.

Subdivision/Mobile Home Park Name _____ Lot Size 1.64 AC

Permit No. # 2672 Lot No. 8R

New System _____ Repair ☒

House _____ Mobile Home ☒ Business _____

No. Bedrooms 3 No. People _____ No. Toilets _____

Water Supply: Private ☒ Approved _____

Semi-Public _____ Unapproved _____

Public _____ None _____

Nitrification System: _____

Tank Size Existing tank + pump tank gal. _____

Distribution Box pressure No. Lines 4

Nitrification Field 1200 Sq. Ft. _____

Lines: 1 2 3 4 5 6

Width 3' 3' 3' 3' _____

Length 105' 105' 105' 105' _____

Grade 1 1/2" 1" 2" 1 1/2" _____

Stone Depth 12" 12" 12" 12" _____

Layout to be followed by installer:

** Sketch of layout on back*


Improvements Permit By David Cumbee Installer Jimmy Lewis

Certificate of Completion By David Cumbee Date of Inspection 9-12-00

* Construction must comply with all other applicable state and local regulations, but the permit is not a guarantee that the system will not malfunction and the Granville-Vance Health District will not be held responsible for a malfunctioning system.

New Sewer Line Laid

NOTE: Make sketch of installation showing location of house, septic tanks, privies, water supplies on adjacent property, etc. Write in measurements in order that installations may be located at later date.

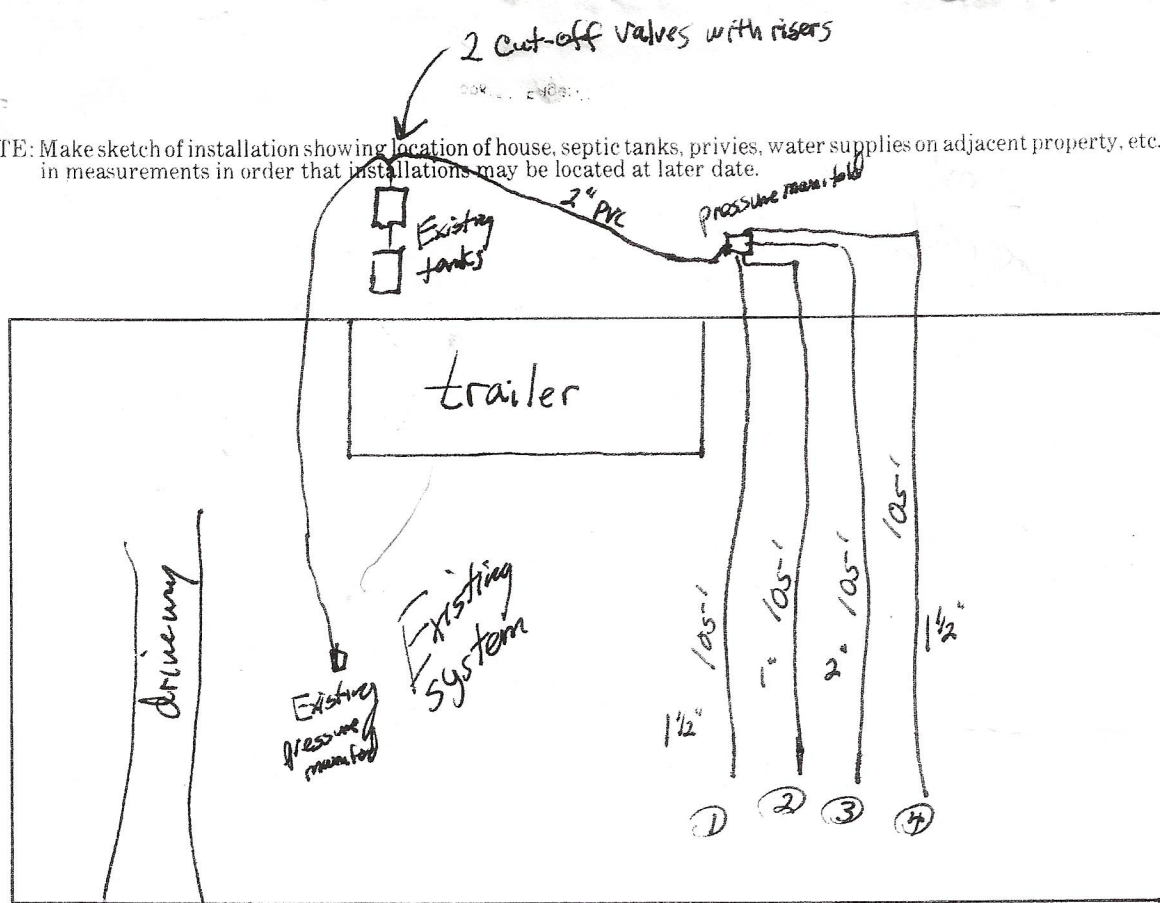

* Septic System - 2000 -

* 1st one in Front Failed!!

Inspection 9/12/2000
 Date for
 new system
 back field
 (moved from front
 to side yard.)

update
 Note: 5/25/2023 - When I
 Bought 3/2007 - Was re-inspected
 as well as the well & the Home