

PERMIT NUMBER 8692

GRANVILLE-VANCE DISTRICT HEALTH DEPARTMENT IMPROVEMENT AND OPERATION PERMITS

COUNTY: <u>Granville</u>	TAX NO. <u>182400121237</u>	TYPE OF ESTABLISHMENTS			*THIS PERMIT SHALL BE ACCOMPANIED BY A LAYOUT SHOWN ON A PLAT, INCLUDING SYSTEM REQUIREMENTS.
SR. NO.	RESIDENCE ☒ BUSINESS ☐ OTHER ☐	NUMBER OF BEDROOMS: <u>4</u>	NUMBER OF OCCUPANTS: <u>8 max!</u>		
APPLICANT: <u>Wynn Const.</u>	WATER SUPPLY <u>Private</u>	WELL PUBLIC ☐	OTHER ☐		
APPLICANT'S NAME & ADDRESS: <u>2550 Capital Blvd. Creedmoor, NC 27522</u>	TYPE OF WASTEWATER SYSTEM	INITIAL INSTALLATION	REPAIR		
PROPERTY ADDRESS/LOCATION: <u>Butterfly Circle</u>	DESIGN FLOW:	<u>480 gpd</u>			*THIS IMPROVEMENT PERMIT IS SUBJECT TO REVOCATION IF THE INTENDED USES CHANGE FROM THOSE SHOWN ON THE IMPROVEMENT PERMIT. CHANGES SHALL REQUIRE HEALTH DEPARTMENT APPROVAL.
SUBDIVISION: <u>Chesleigh</u>	LTAR:	<u>.3 gpd/ft²</u>			
LOT NUMBER: <u>122</u>	ABSORPTION AREA:	<u>1600 ft²</u>			
REFERENCE SKETCH (SEE PLAT FOR DETAILS) <u>* Maintain Setbacks</u>	TRENCH WIDTH:	<u>3'</u>			
	TRENCH DEPTH:	<u>18-20"</u>			PERMIT VALID FOR: 5 YEARS ☒ YES ☐ NO
	TRENCH SPACING:	<u>9' o.c.</u>			
	TOTAL TRENCH LENGTH:	<u>400' Accepted</u>			
	NUMBER OF TRENCHES:	<u>3 or 4</u>			
	GRAVEL DEPTH:	<u>Accepted</u>			NO EXPIRATION YES ☐ NO ☒
	TANK SIZE:	<u>1000 gal</u>			
	PUMP TANK SIZE:	<u>—</u>			
	DISTRIBUTION DEVICE:	<u>D-Box</u>			

***** IMPROVEMENT PERMIT DATE: 6-8-16 *****

FOR: Wynn Construction
ISSUED BY: Adam Curran

CONSTRUCTION AUTHORIZATION FOR IMPROVEMENT PERMIT# 8692

Unless otherwise indicated, the same conditions above apply regarding system type, layout, location and installation requirements.

(The wastewater system cannot be installed until authorization is signed)

Comments: Contractor to establish & follow center




Date: 6-8-16 Environmental Health Specialist: Adam Curran
Construction Authorization Addendum ☒ Yes ☐ No

OPERATION PERMIT

DATE:

SYSTEM INSTALLED BY: _____
ISSUED BY: _____

PERFORMANCE, MONITORING, MAINTENANCE AND OPERATION
AS REQUIRED BY RULE .1961

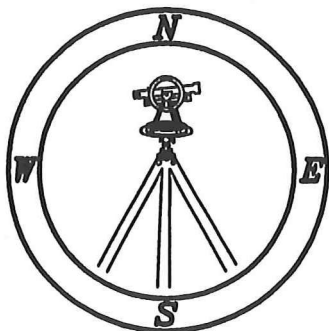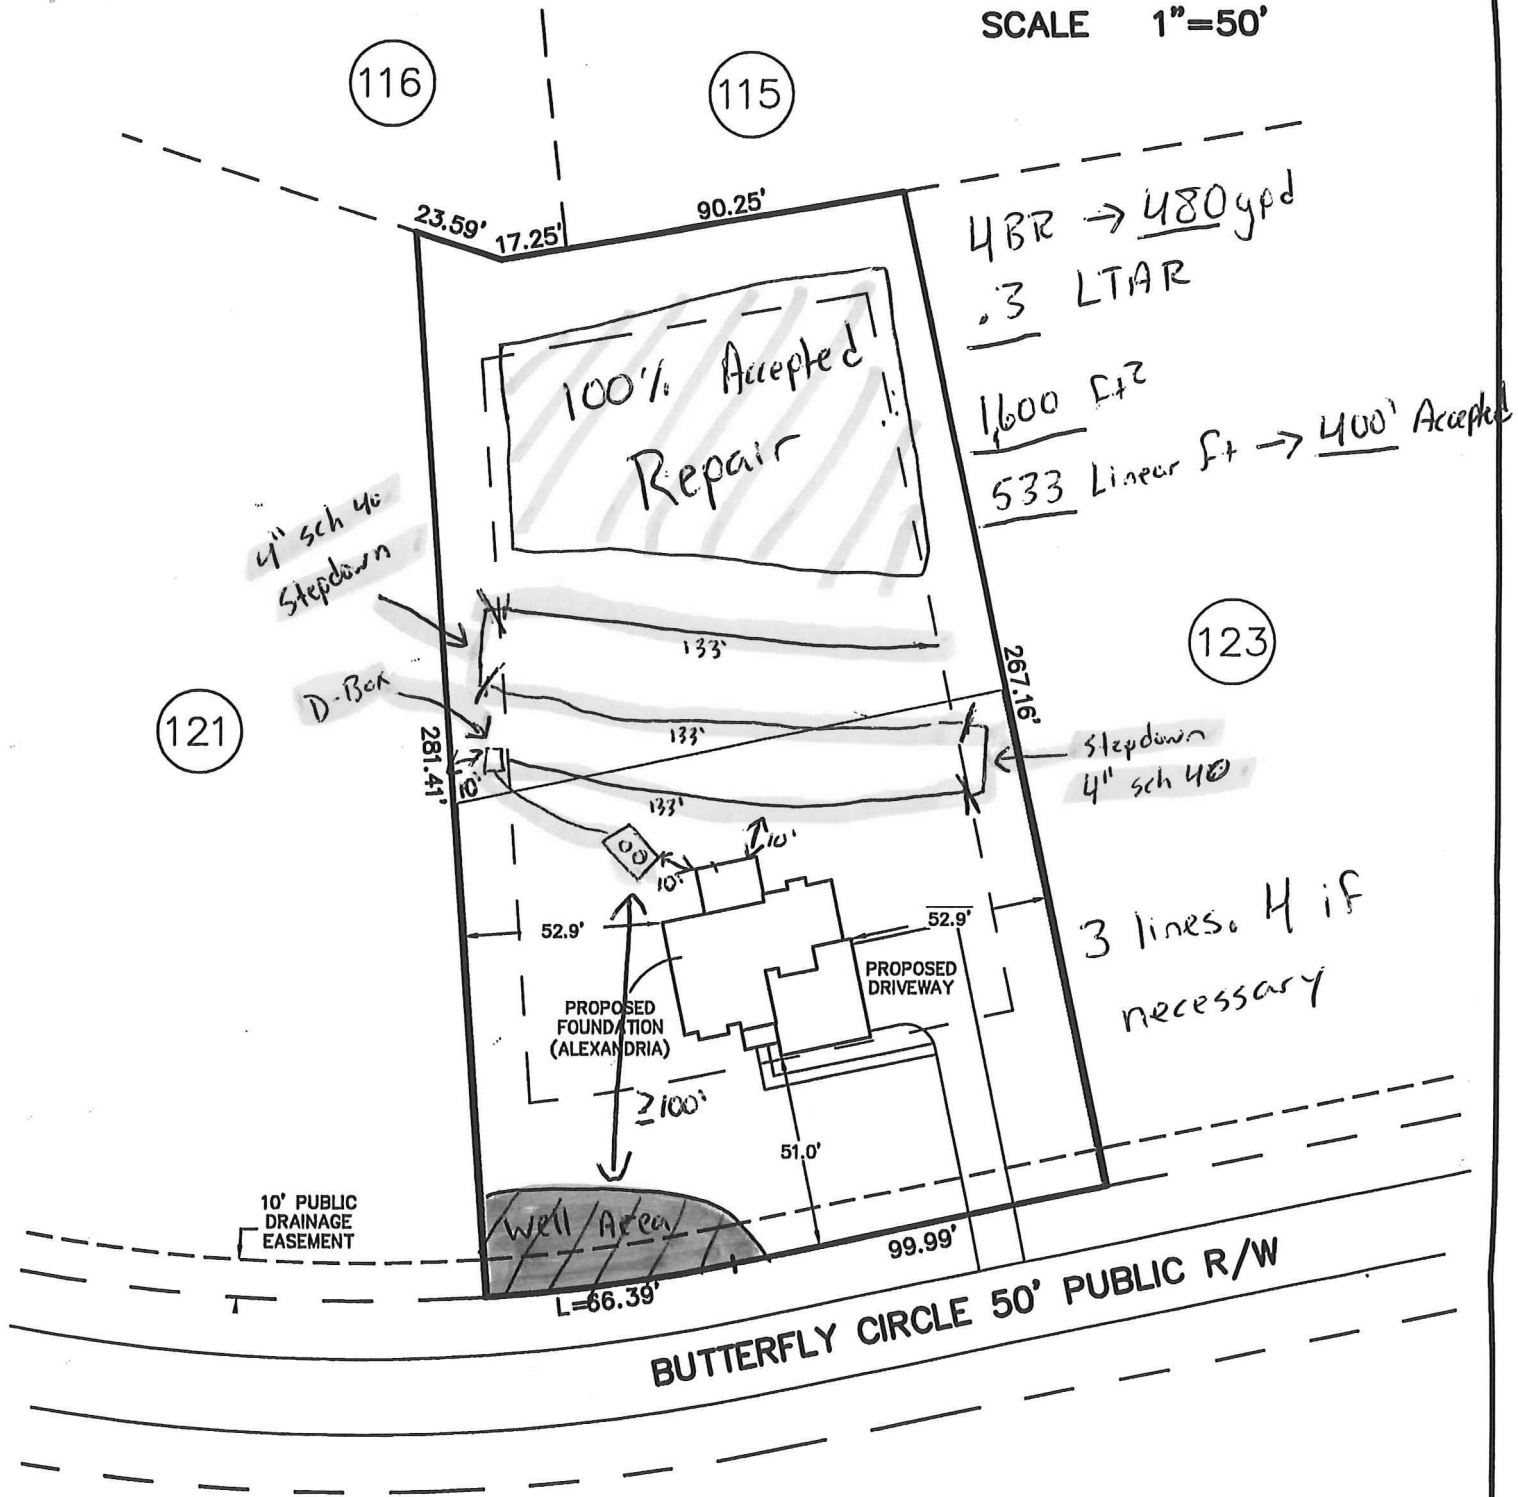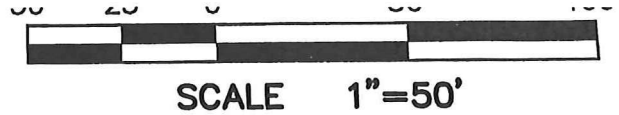

CAWTHORNE, MOSS & PANCIERA, P.C.

Professional Land Surveyors
C-1525

333 S. White Street
Post Office Box 1253
Wake Forest, N.C. 27588
(919)556-3148

NOTES:

- THIS PLAN DOES NOT REFLECT AN ACTUAL SURVEY. IT IS A PRELIMINARY PLAN AND SHOULD BE USED FOR ITS INTENDED PURPOSE ONLY.
- NOT FOR RECORDATION, CONVEYANCES, OR SALES.