

GRANVILLE-VANCE DISTRICT HEALTH DEPARTMENT IMPROVEMENT AND OPERATION PERMITS

COUNTY:	TAX NO.	TYPE OF ESTABLISHMENTS			*THIS PERMIT SHALL BE ACCOMPANIED BY A LAYOUT SHOWN ON A PLAT, INCLUDING SYSTEM REQUIREMENTS.
Granville	LOT SIZE	RESIDENCE ☒ BUSINESS ☐ OTHER ☐	NUMBER OF BEDROOMS: 3	NUMBER OF OCCUPANTS: 6 MAX	
APPLICANT'S NAME & ADDRESS		WATER SUPPLY WELL ☒ PUBLIC ☐	INITIAL INSTALLATION	REPAIR	
Trabar Homes		TYPE OF WASTEWATER SYSTEM	IIIg	IIIbg	*THIS IMPROVEMENT PERMIT IS SUBJECT TO REVOCATION IF THE INTENDED USE CHANGES FROM THOSE SHOWN ON THE IMPROVEMENT PERMIT. CHANGES SHALL REQUIRE HEALTH DEPARTMENT APPROVAL.
PROPERTY ADDRESS/LOCATION:		DESIGN FLOW:	360 gpd		
Shonelle Ln.		LTAR:	275 gpd/Ft ²		
SUBDIVISION:		ABSORPTION AREA:	981 Ft ²		
Rangewood		TRENCH WIDTH	36"		
LOT NUMBER: 17		TRENCH DEPTH:	20-24"		
REFERENCE SKETCH (SEE PLAT FOR DETAILS)		TRENCH SPACING:	9' o.c.		
* Risers on tank		TOTAL TRENCH LENGTH:	330'		
		NUMBER OF TRENCHES:	3		
		GRAVEL / ACCEPTED:	Accepted		
		TANK SIZE:	1000 gal		PERMIT VALID FOR 5 YEARS YES NO
		PUMP TANK SIZE:	N/A		NO EXPIRATION YES NO
		DISTRIBUTION DEVICE:	D-Box		

IMPROVEMENT PERMIT

DATE: 3-29-19

FOR: Trabar Homes

ISSUED BY: Delann Corrin

CONSTRUCTION AUTHORIZATION FOR IMPROVEMENT PERMIT# 1329

Unless otherwise indicated, the same conditions above apply regarding system type, layout, location and installation requirement.

(The wastewater system cannot be installed until authorization is signed)

Comments:

Date: 3-29-19

Environmental Health Specialist:

Delann Corrin

 Construction Authorization Addendum ☒ Yes ☐ No

OPERATION PERMIT

DATE:

SYSTEM INSTALLED BY:

ISSUED BY:

PERFORMANCE, MONITORING, MAINTENANCE AND OPERATION

AS REQUIRED BY R.U.L.E. 1961

PIN _____

Granville-Vance District Health Department

Permit Number 5-1329

W-2744

Environmental Health

☒ **Improvement Permit**

☒ **Construction Authorization**

Site Sketch

Trabar Homes

Applicant's Name

Chlorine Green


Authorized Signature

Rangewood / 17

Address/Subdivision-Lot Number

3-29-19

Date

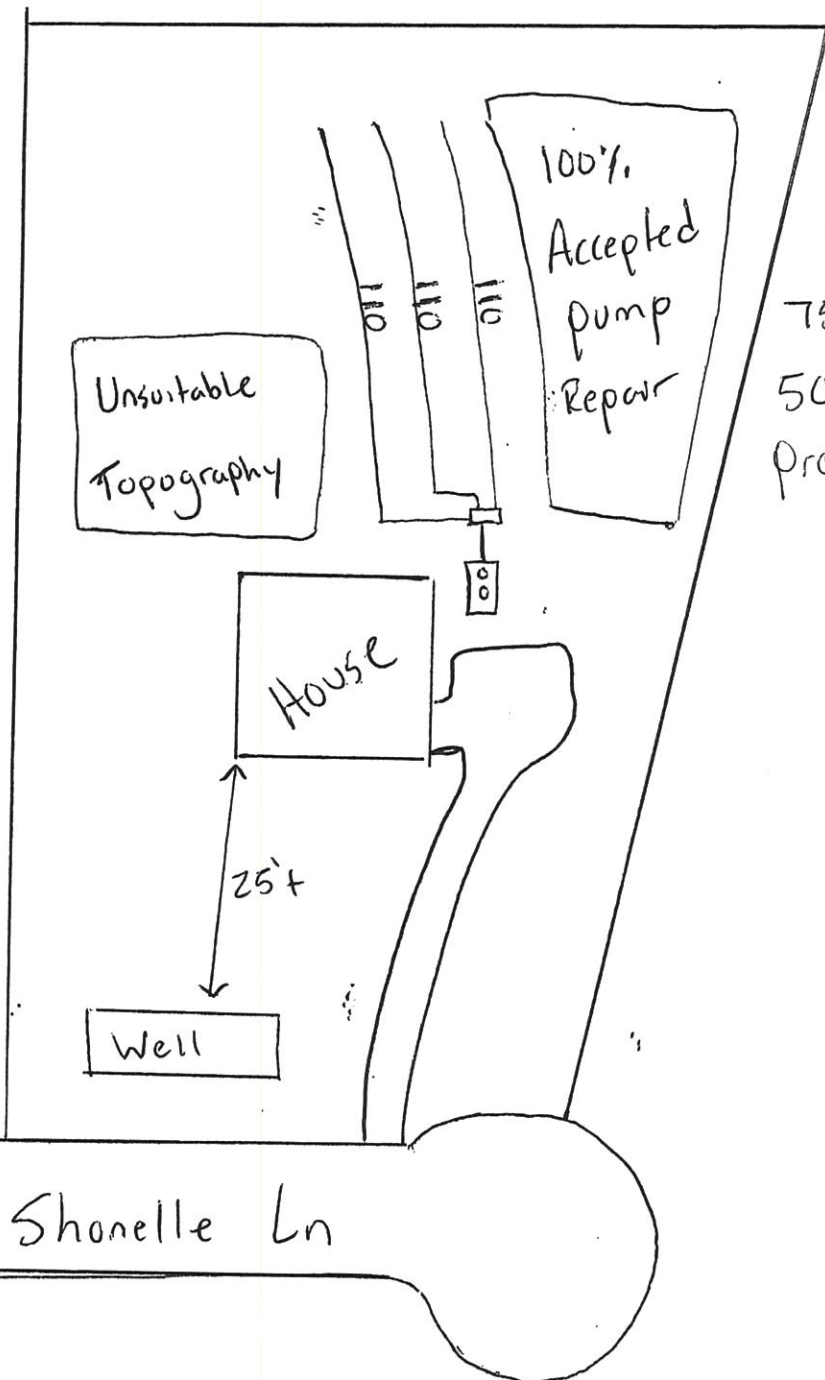

*House sits
75' off Rd and
50' off both side
property lines.

Granville - Vance District Health Department

Environmental Health

Well Construction Permit

2744

Owner/Applicant: Trabar Homes
 Address or Location of Property: Shonelle Ln

Date: 3-29-19

Subdivision & Lot #: Rangerwood / 17
 Zoning Permit #: 204450

Septic Permit #: 1329
 Environmental Health Specialist: AWC

This well permit is to locate and site the area that a private groundwater well may be established on the property listed above by the Environmental Health Specialists of Granville County. If one does not locate the well in the approved area and complete the well as specified by the 15A NCAC .02C rules, then permits may be revoked. At completion of drilling of the well, grout must be witnessed by EHS and a well log turned into Environmental Health.

Minimum Setbacks: (these are the main setbacks, but not all required setbacks)


Setback from property lines – 10 ft

Setback from septic tank and drain field, including repair area – 100 ft

Setback from structural foundations – 25 ft

Setback from ponds, lakes or other bodies of water – 50 ft

Site Sketch:

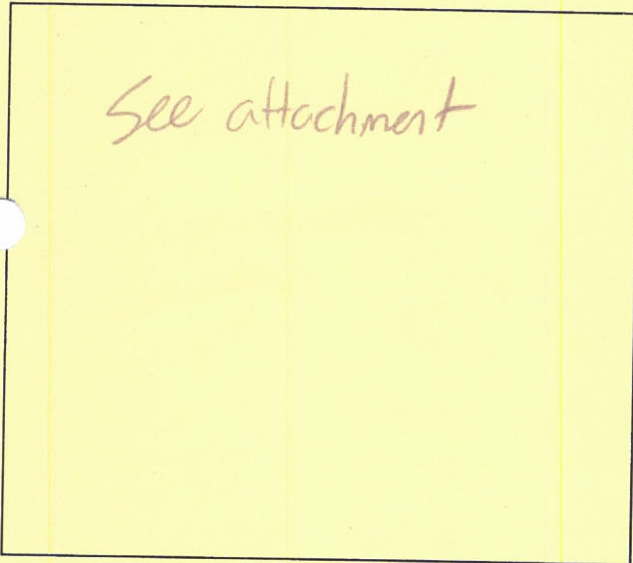

Conditions: _____

Authorized Agent: Adam Crowe
Date: _____

1 Well Grout: (Circle or write in)

Witnessed: Yes or No EHS Agent: _____
 Date: _____ Annular Space Open: Yes or No
 Over reamed: Yes or No Depth Grouted: _____
 Method: _____ Pump _____ Poured _____ Pressure
 Well Log received: Yes or No (EHS to Attach to Permit)
 Driller Name: _____ Cert. # _____
 Depth: _____ Casing Depth: _____ GPM: _____

2 Well Final: (Place a check mark when finalized)

Seal Present and Intact: _____ Air Vent: _____
 Hose Spigot: _____ Electrical Box: _____
 Pump Installer Tag: _____ Well Installer Tag: _____
 All holes sealed: _____ 12" above grade: _____

Comments: _____

3 Well Completion Permit: _____ **EHS**
Date Completed: _____

4 Water Samples Taken: Date: _____

EHS: _____ **Results:** _____
Retest: _____ **Results:** _____

As Built Drawing:

