

PERMIT NUMBER 8430

GRANVILLE-VANCE DISTRICT HEALTH DEPARTMENT IMPROVEMENT AND OPERATION PERMITS

COUNTY:	TAX NO. <u>183600586745</u>	TYPE OF ESTABLISHMENTS			*THIS PERMIT SHALL BE ACCOMPANIED BY A LAYOUT SHOWN ON A PLAT, INCLUDING SYSTEM REQUIREMENTS.
<u>Granville</u>	SR. NO.	RESIDENCE ☒ BUSINESS ☐ OTHER ☐	NUMBER OF BEDROOMS: <u>3</u>	NUMBER OF OCCUPANTS: <u>6 max</u>	
APPLICANT: <u>NC Exteriors</u>		WATER SUPPLY <u>Private</u>	WELL ☒ PUBLIC ☐	OTHER ☐	
APPLICANT'S NAME & ADDRESS: <u>9350 Falls of the Horse System 100 Raleigh, NC 27615</u>		TYPE OF WASTEWATER SYSTEM	INITIAL INSTALLATION	REPAIR	
PROPERTY ADDRESS/LOCATION: <u>4290 Sustain Circle</u>		DESIGN FLOW:	<u>360 GPD</u>		*THIS IMPROVEMENT PERMIT IS SUBJECT TO REVOCATION IF THE INTENDED USES CHANGE FROM THOSE SHOWN ON THE IMPROVEMENT PERMIT. CHANGES SHALL REQUIRE HEALTH DEPARTMENT APPROVAL.
SUBDIVISION: <u>Golden Forest</u>		LTAR:	<u>.3 GPD/sf²</u>		
LOT NUMBER: <u>18</u>		ABSORPTION AREA:	<u>1200 ft²</u>		
REFERENCE SKETCH (SEE PLAT FOR DETAILS)		TRENCH WIDTH:	<u>3'</u>		
		TRENCH DEPTH:	<u>22'</u>		
		TRENCH SPACING:	<u>9' o.c.</u>		
		TOTAL TRENCH LENGTH:	<u>300'</u>		
		NUMBER OF TRENCHES:	<u>3 or 4</u>		
		GRAVEL DEPTH:	<u>accepted</u>		
		TANK SIZE:	<u>1000 Gallons</u>		
		PUMP TANK SIZE:	<u>NA</u>		PERMIT VALID FOR: 5 YEARS YES ☒ NO ☐
		DISTRIBUTION DEVICE:	<u>D'Boy</u>		NO EXPIRATION YES ☐ NO ☒

IMPROVEMENT PERMIT

DATE: 12/9/15

FOR: NC Exteriors

ISSUED BY: Chris Hall

CONSTRUCTION AUTHORIZATION FOR IMPROVEMENT PERMIT# 8430

Unless otherwise indicated, the same conditions above apply regarding system type, layout, location and installation requirements.
(The wastewater system cannot be installed until authorization is signed)

Comments: Contractor to establish & follow contract.

Date: 12/9/15 Environmental Health Specialist: Chris Hall

Construction Authorization Addendum ☒ Yes ☐ No


OPERATION PERMIT

DATE: 6-14-16

SYSTEM INSTALLED BY: Truworks

ISSUED BY: Adam Cummings

PERFORMANCE, MONITORING, MAINTENANCE AND OPERATION
AS REQUIRED BY RULE .1961

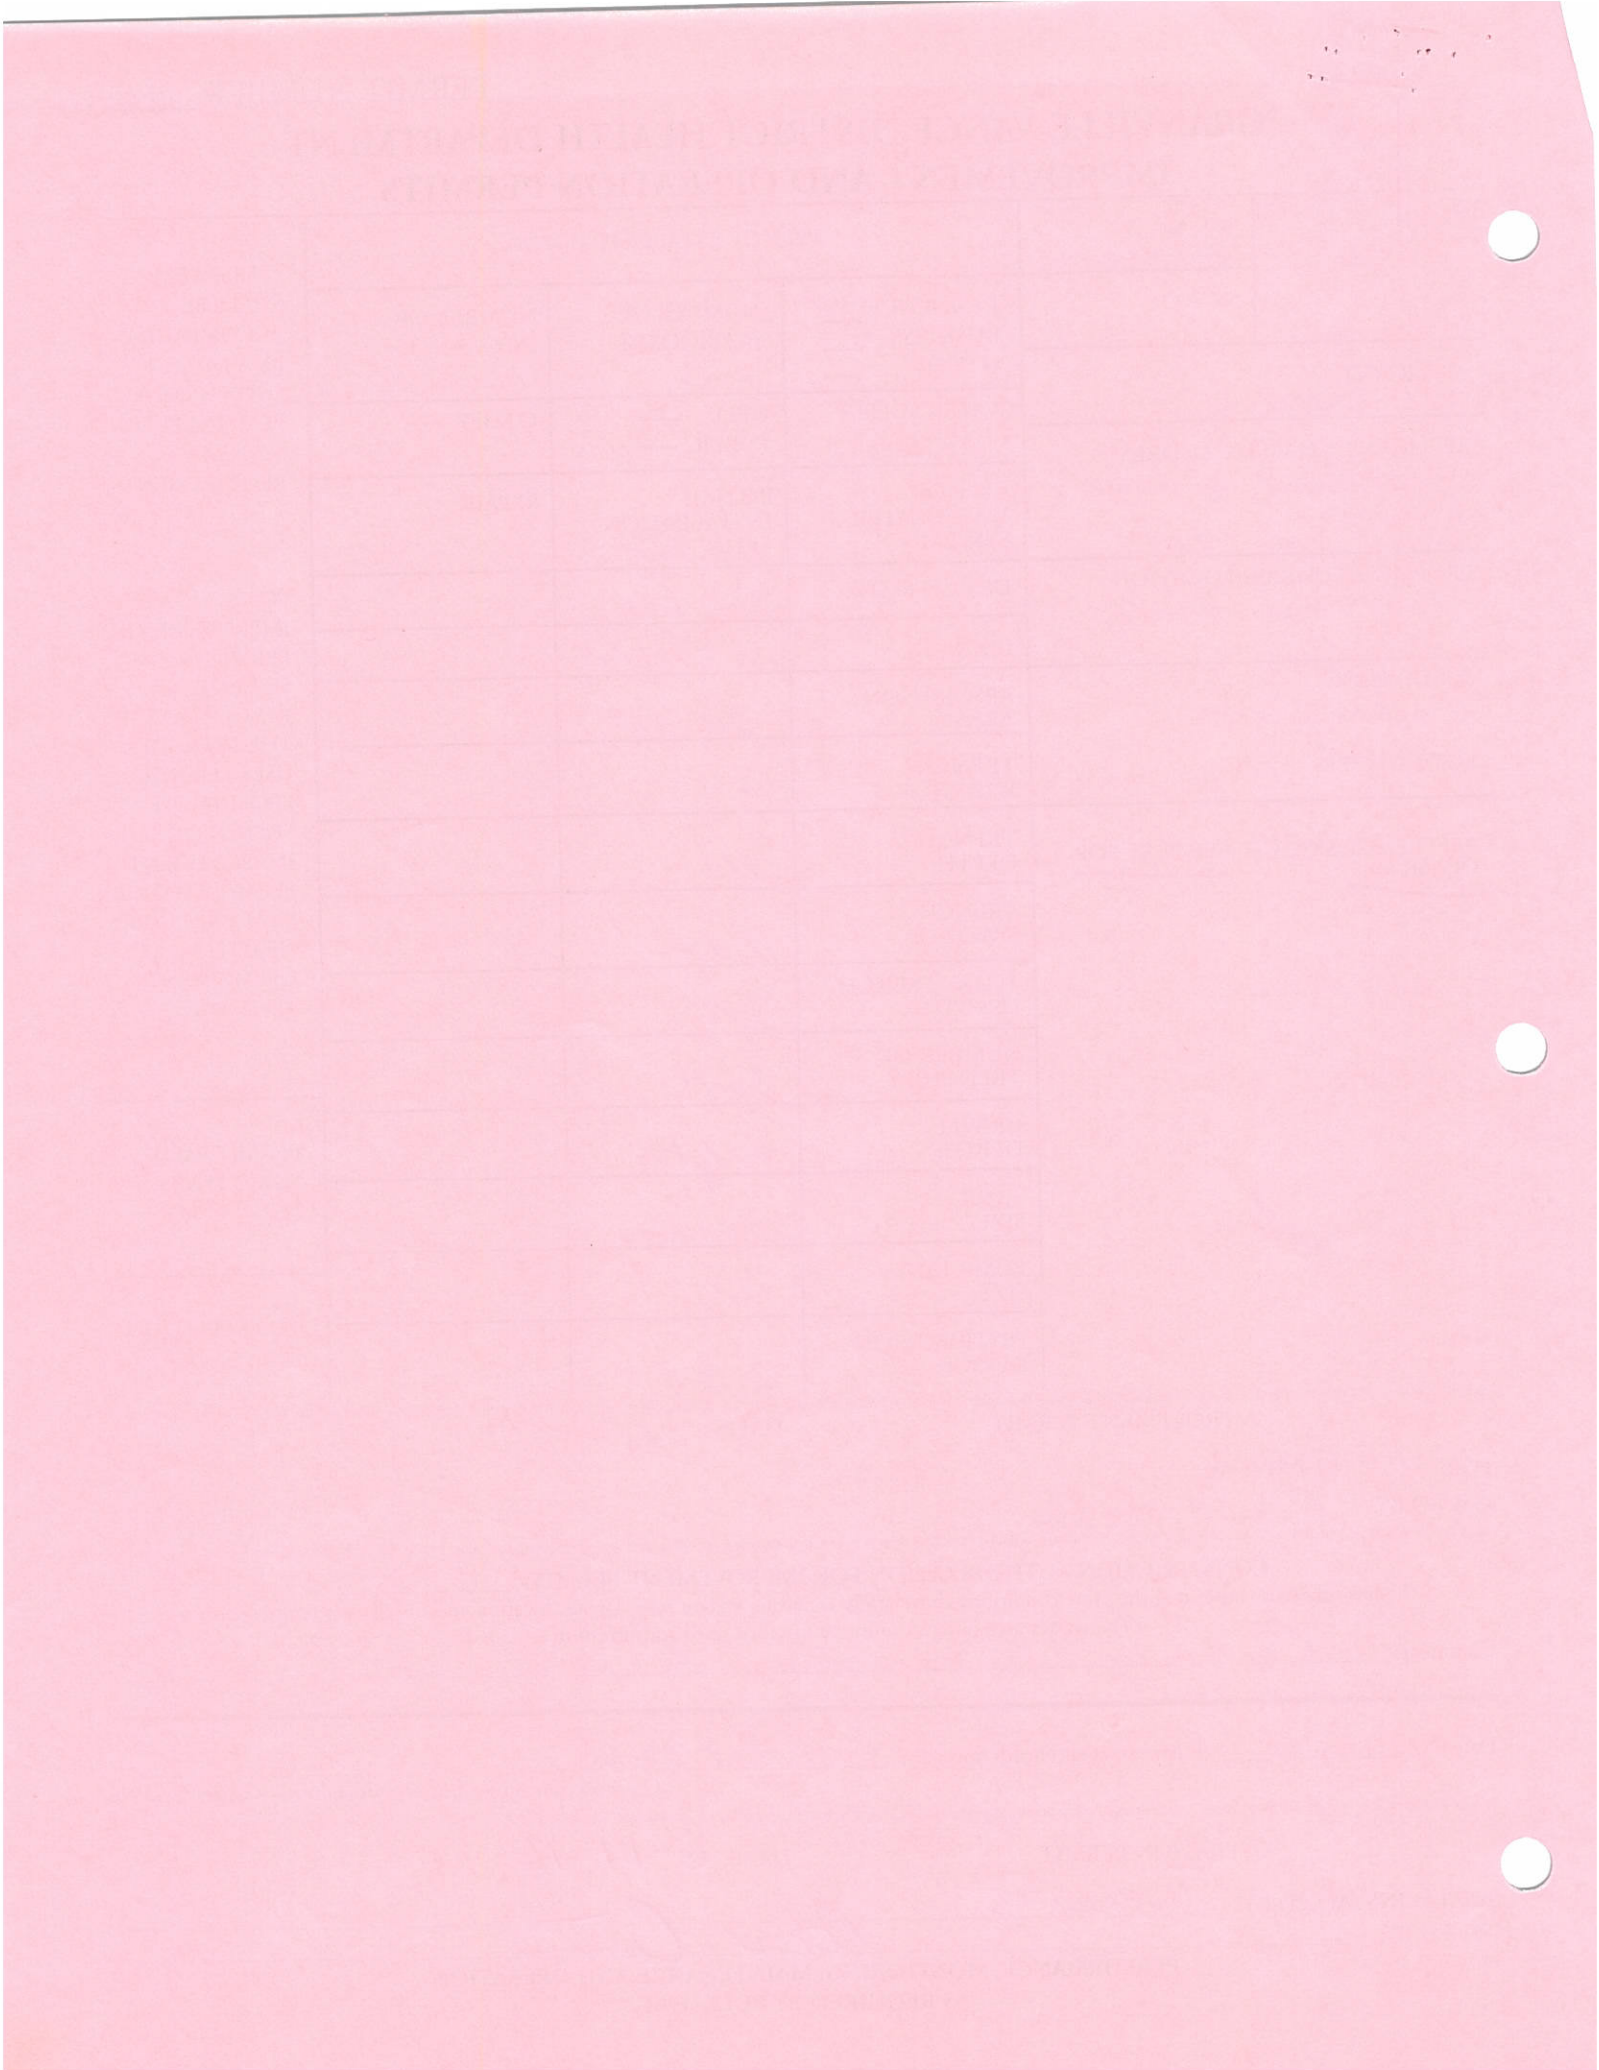

Granville - Vance District Health Department
Environmental Health

Final Sketch

Pin 183600586745

Improvement Permit

Construction Authorization

N.C. Exteriors
Applicant's Name

Permit No. 8430


Golden Forest / 18
Subdivision - Section - Lot

Physical Address: 4290 Sustain Circle

Treeworks
System Installer

6-14-16
Date

System design and details as installed.

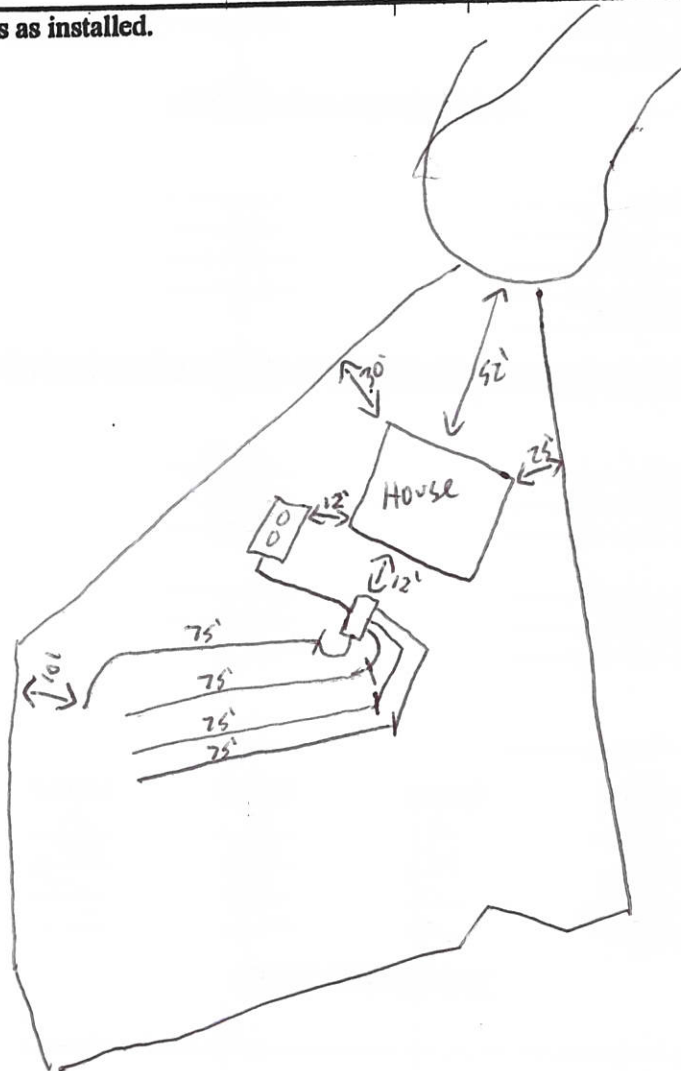

Robert Currier
Authorized Signature

6-13-16

Date

SEWAGE DISPOSAL SYSTEM INSTALLATION REVIEW

SEPTIC AND PUMP TANK INSPECTION

SEPTIC TANK

Manufacturer DB
 Date of Manufacture 5-8-16
 Stamp STB-502
 Capacity 1000
 Tee ✓
 Baffle ✓
 Sealant ✓
 AIR GAP ✓, FILTER ✓, RISER ✓

INITIAL

awc
✓
✓
DATE

6-14-16
✓
✓
PUMP TANK

Manufacture _____
 Date of Manufacture _____
 Stamp _____
 Capacity _____
 Sealant _____
 Manhole _____
 RISER _____, SEALANT _____

MECHANICAL INSPECTION

PUMP

Manufacturer and Model # _____
 Control Panel _____
 Alarm _____
 Electrical Connection _____
 SEALANT AROUND CONDUIT _____

NITRIFICATION/DISTRIBUTION AND DRAINFIELD INSPECTION

DISTRIBUTION BOX

Level ✓
 Equal Distribution ✓
 Other _____

awc
✓
✓
✓
✓

6-14-16
✓
✓
✓
✓

DISTRIBUTION MANIFOLD

Pipe Size _____
 Gate Valves _____
 Other _____

OTHER DISTRIBUTION

Type _____

NITRIFICATION LINES

Trench Width 3'
 Trench Length 75'
 Trench Grade ✓
 Stone Depth ✓

LINE 1

LINE 2

LINE 3

LINE 4

LINE 5

LINE 6

3'
75'
✓
✓

3'
75'
✓
✓

3'
75'
✓
✓

3'
75'
✓
✓

WELL INSPECTION

LOCATION OF WELL

COMMENTS:

poly styrene