

Granville - Vance District Health Department

Environmental Health

1732

Well Construction Permit


Owner/Applicant: NC ExteriorsDate: 12/9/15Address or Location of Property: 4290 Sustain CircleSubdivision & Lot #: Golden Forest 18Septic Permit #: 8430Zoning Permit #: 18964Environmental Health Specialist: CAVE

This well permit is to locate and site the area that a private groundwater well may be established on the property listed above by the Environmental Health Specialists of Granville County. If one does not locate the well in the approved area and complete the well as specified by the 15A NCAC .02C rules, then permits may be revoked. At completion of drilling of the well, grout must be witnessed by EHS and a well log turned into Environmental Health.

Minimum Setbacks: (these are the main setbacks, but not all required setbacks)

Setback from property lines 10 ftSetback from septic tank and drain field, including repair area - 100 ftSetback from structural foundations 25 ftSetback from ponds, lakes or other bodies of water - 50 ft

Site Sketch:

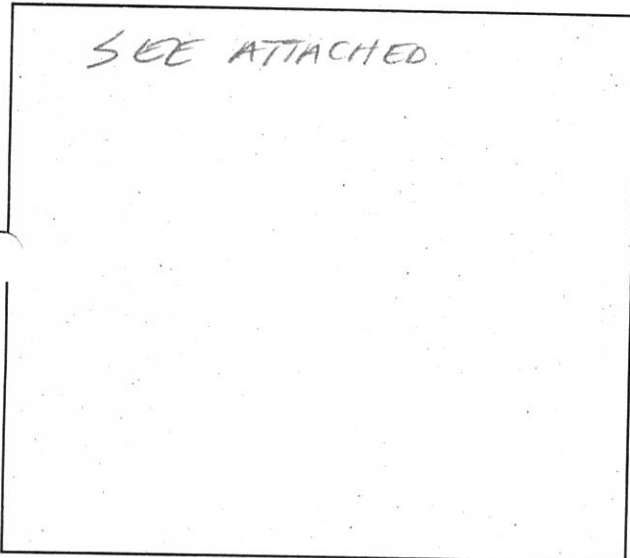

Conditions:

Authorized Agent: Chris HallDate: 12/9/15


1 Well Grout: (Circle or write in)

Witnessed: Yes or No EHS Agent: Chris HallDate: 12/2/16 Annular Space Open: Yes or NoOver reamed: Yes or No Depth Grouted: 20+Method: Pump ☒ Poured ☐ Pressure

Well Log received: Yes or No (EHS to Attach to Permit)

Driller Name: DAVIS Cert. # Depth: 305' Casing Depth: 112' GPM: 5

As Built Drawing:

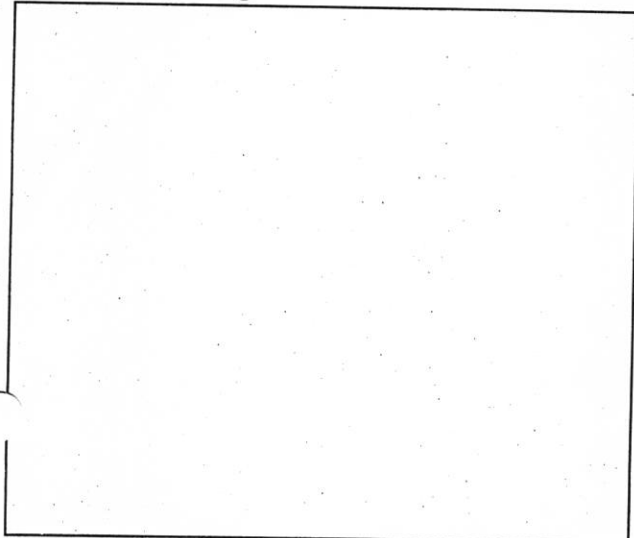

2 Well Final: (Place a check mark when finalized)

Seal Present and Intact: ☒ Air Vent: ☒Hose Spigot: ☒ Electrical Box: ☒Pump Installer Tag: ☒ Well Installer Tag: ☒All holes sealed: ☒ 12" above grade: ☒Comments: # 3 Well Completion Permit: Adam Cummings EHSDate Completed: 8-10-16# 4 Water Samples Taken: Date: 8-10-16EHS: Adam CummingsResults: Retest: Results:

