

GRANVILLE-VANCE HEALTH DEPARTMENT—Sewage Disposal Record

Owner or Contractor A+M Remodeling Date 10-29-07 S.R. No. 1711
 Location/Address Antenna Dr.
 Subdivision/Mobile Home Park Name Marshall Landing Lot Size _____
 Permit No. # 6368 Lot No. 32

New System ☒ Repair _____
 House ☒ Mobile Home _____ Business _____
 No. Bedrooms 3 No. People _____ No. Toilets _____
 Water Supply: Private ☒ Approved _____
 Semi-Public _____ Unapproved _____
 Public _____ None _____

Nitrification System:

Tank Size 1000 gal.
 Distribution Box ☒ No. Lines 3
 Nitrification Field 900 Sq. Ft.
 Lines:


1	2	3	4	5	6
Width <u>3'</u>	<u>3'</u>	<u>3'</u>			
Length <u>100'</u>	<u>100'</u>	<u>100'</u>			
Grade <u>0"</u>	<u>0"</u>	<u>0"</u>			
Stone Depth <u>E-2-</u>	<u>Flow</u>				

Layout to be followed by installer:

Improvements Permit By DAVID CUMBERS, RS Installer True Works
 Certificate of Completion By Jim B. C. J. S. Date of Inspection 10-29-07

* Construction must comply with all other applicable state and local regulations, but the permit is not a guarantee that the system will not malfunction and the Granville-Vance Health District will not be held responsible for a malfunctioning system.

NOTE: Make sketch of installation showing location of house, septic tanks, privies, water supplies on adjacent property, etc. Write in measurements in order that installations may be located at later date.

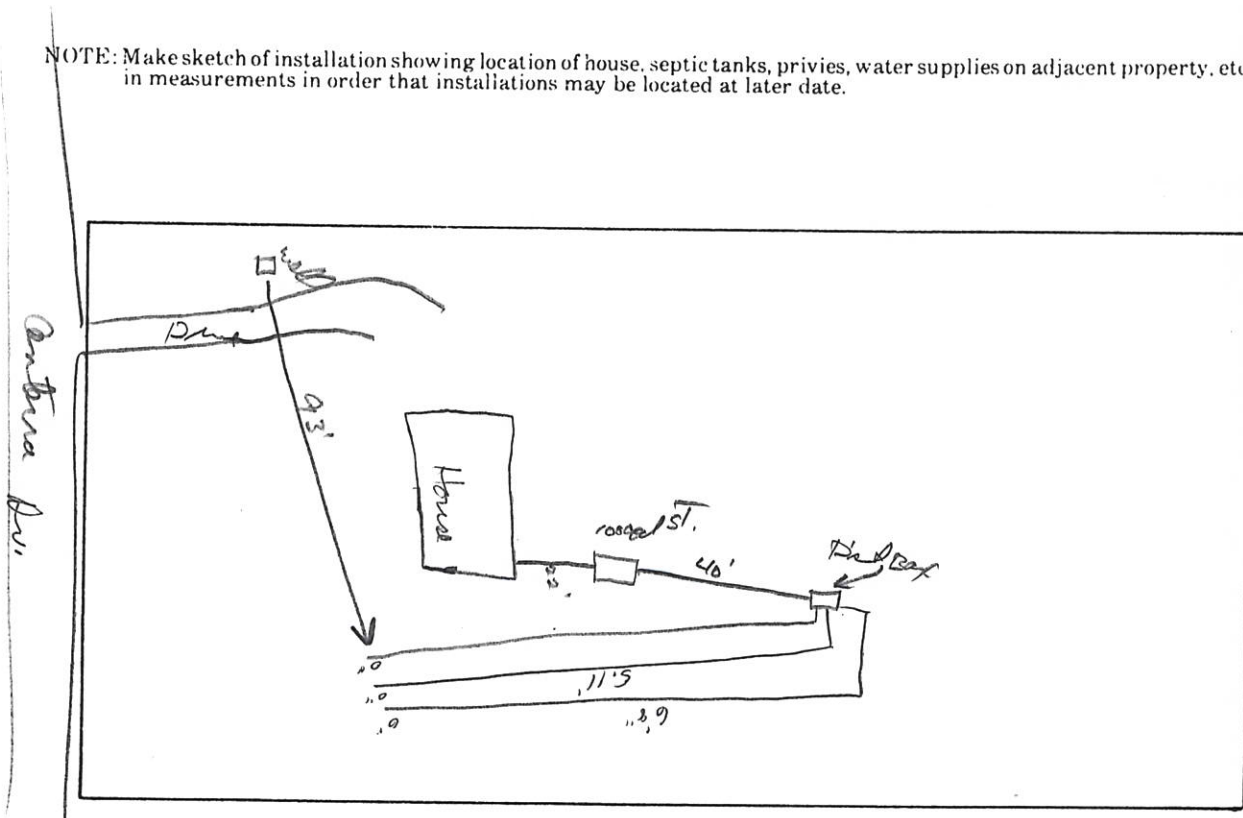

PERMIT NUMBER

GRANVILLE-VANCE DISTRICT HEALTH DEPARTMENT IMPROVEMENT AND OPERATION PERMITS

COUNTY:	TAX NO.	TYPE OF ESTABLISHMENTS			*THIS PERMIT SHALL BE ACCOMPANIED BY A LAYOUT SHOWN ON A PLAT, INCLUDING SYSTEM REQUIREMENTS.
Granville	152400691915	RESIDENCE ☒	NUMBER OF BEDROOMS:	NUMBER OF OCCUPANTS:	
OWNER:	SR. NO.	BUSINESS ☐	3	spec.	
A+M Remodeling	1111	OTHER ☐	WATER SUPPLY	WELL ☒	
APPLICANT'S ADDRESS:		TYPE OF WASTEWATER SYSTEM	INITIAL INSTALLATION	REPAIR	*THIS IMPROVEMENT PERMIT IS SUBJECT TO REVOCATION IF THE INTENDED USES CHANGE FROM THOSE SHOWN ON THE IMPROVEMENT PERMIT. CHANGES SHALL REQUIRE HEALTH DEPARTMENT APPROVAL.
P.O. Box 1496		DESIGN FLOW:	Type III-g	Type III-g (pump)	
Wake Forest, NC 27588		LTAR:	360 gpd	3 gpd/ft ²	
PROPERTY ADDRESS/LOCATION:		ABSORPTION AREA:	* 1200 ft ²		
Antenna Drive		TRENCH WIDTH:	3'		
SUBDIVISION:		TRENCH DEPTH:	22"		
Marshall Landing		TRENCH SPACING:	9' o.c.		
LOT NUMBER:		TOTAL TRENCH LENGTH:	* 300'		
32		NUMBER OF TRENCHES:	3		
REFERENCE SKETCH (SEE PLAT FOR DETAILS)		GRAVEL DEPTH:	* Accepted status	(non-gravel)	PERMIT VALID FOR: 5 YEARS YES ☒ NO ☐
Tines dug level, and on contour		TANK SIZE:	1000 gal.		
Contour flagged by Health Dept. (blue)		PUMP TANK SIZE:			NO EXPIRATION YES ☐ NO ☒
Stay on 9' centers to save repair space - do not install in wet weather		DISTRIBUTION DEVICE:	Distribution box		

***** IMPROVEMENT PERMIT DATE: 6-5-07 *****

FOR: A+M Remodeling
ISSUED BY: Dan Cummins

CONSTRUCTION AUTHORIZATION FOR IMPROVEMENT PERMIT# 06368

Unless otherwise indicated, the same conditions above apply regarding system type, layout, location and installation requirements.
(The wastewater system cannot be installed until authorization is signed)

Comments: Call 693-2688 if any questions

Date: 6-5-07 Environmental Health Specialist: [Signature] Construction Authorization Addendum ☐ Yes ☒ No

***** OPERATION PERMIT DATE: 10-29-07 *****

SYSTEM INSTALLED BY: True Works
ISSUED BY: [Signature]

PERFORMANCE, MONITORING, MAINTENANCE AND OPERATION
AS REQUIRED BY RULE .1961