

PERMIT NUMBER **07698**

**GRANVILLE-VANCE DISTRICT HEALTH DEPARTMENT
IMPROVEMENT AND OPERATION PERMITS**

Zoning # 18071

COUNTY:	TAX NO.	TYPE OF ESTABLISHMENTS			*THIS PERMIT SHALL BE ACCOMPANIED BY A LAYOUT SHOWN ON A PLAT, INCLUDING SYSTEM REQUIREMENTS.
OWNER: <i>Sallinger Construction</i>	SR. NO.	RESIDENCE ☒	NUMBER OF BEDROOMS:	NUMBER OF OCCUPANTS:	
		BUSINESS ☐	<i>4</i>	<i>8 max.</i>	
		OTHER ☐			
APPLICANT'S ADDRESS:		WATER SUPPLY	WELL ☐	OTHER ☐	*THIS IMPROVEMENT PERMIT IS SUBJECT TO REVOCATION IF THE INTENDED USES CHANGE FROM THOSE SHOWN ON THE IMPROVEMENT PERMIT. CHANGES SHALL REQUIRE HEALTH DEPARTMENT APPROVAL.
<i>1029 Harpers Ridge Ct. Wake Forest, 21587</i>		TYPE OF WASTEWATER SYSTEM	INITIAL INSTALLATION	REPAIR	
PROPERTY ADDRESS/LOCATION:		DESIGN FLOW:			
<i>671 Juliette Ct.</i>		LTAR:	<i>3 gpd/ft²</i>		
SUBDIVISION:		ABSORPTION AREA:	<i>1600 ft² → 1200 ft²</i>		
<i>Hawthorne</i>		TRENCH WIDTH:	<i>3'</i>		
LOT NUMBER:		TRENCH DEPTH:	<i>18"-20" maximum</i>		
<i>119</i>		TRENCH SPACING:	<i>9' o.c.</i>		
REFERENCE SKETCH (SEE PLAT FOR DETAILS)		TOTAL TRENCH LENGTH:	<i>400'</i>		
<i>> Install trenches level, on contour and in dry conditions</i>		NUMBER OF TRENCHES:	<i>4</i>		
<i>> Septic Contractor & Clearing Contractor should coordinate drainfield clearing - contours estimated by Health Dept.</i>		GRAVEL DEPTH:	<i>Accepted Status</i>		
		TANK SIZE:	<i>1200 gal</i>		
		PUMP TANK SIZE:			
		DISTRIBUTION DEVICE:	<i>Distribution Box</i>		

PERMIT VALID FOR: 5 YEARS
YES ☒ NO ☐

NO EXPIRATION
YES ☒ NO ☐

IMPROVEMENT PERMIT

DATE: *12/4/13*

FOR:

ISSUED BY:

CONSTRUCTION AUTHORIZATION FOR IMPROVEMENT PERMIT# *7698*

Unless otherwise indicated, the same conditions above apply regarding system type, layout, location and installation requirements.

(The wastewater system cannot be installed until authorization is signed)

Comments:

Call 919-693-2688 w/ questions

Date:

12/4/13

Environmental Health Specialist:

David Cumber

Construction Authorization Addendum

☐ Yes ☒ No

OPERATION PERMIT

DATE: *10-9-14*

SYSTEM INSTALLED BY:

ISSUED BY:

David Cumber

PERFORMANCE, MONITORING, MAINTENANCE AND OPERATION
AS REQUIRED BY RULE .1961

Granville - Vance District Health Department
Environmental Health

Pin 181300286442

Permit Number _____

☒ Improvement Permit

☐ Construction Authorization

Final Sketch

Sallinger Construction
Applicants Name

Hawthorne - lot 119
Subdivision - Section Lot

Physical Address: 677 Juliette Ct

BRANTLEY
System Installer

10-9-14
Date

System design and details as installed.

Septic Tank Information:

Date: 6-11-14

Manufacture: DB-1250

ID #: STB-398

Pump Tank Information:

Date: _____

Manufacturer: _____

ID #: _____

Distribution Box ☒

Pressure Manifold _____

Serial Distribution _____

Pump Info: _____

Type of Facility: Residence

Type of System: ☒ Gravity _____

Pump _____


Number of Bedrooms: 4

Gravel ☒ Polystyrene _____

Well Drilled: Not at insp

Chamber _____ Other: _____

- System had to be
cleared
- had to wait 1 1/2
before system
ready.

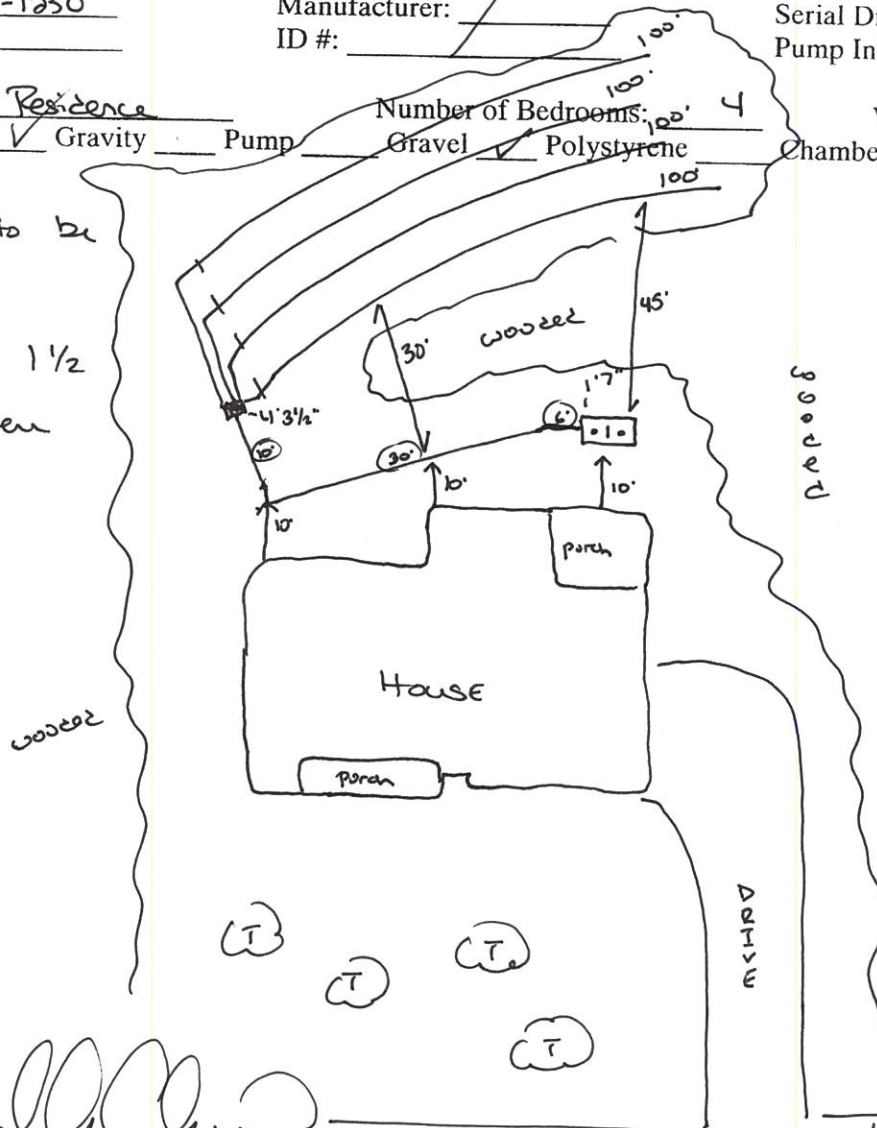

Casey Chapman
Authorized Signature

10-9-14
Date

No well at time
of inspection

Granville - Vance District Health Department

01162

Environmental Health

Well Construction Permit

Owner/Applicant: Sallinger Construction Date: 12/4/13
Address or Location of Property: 677 Juliette Court


Subdivision & Lot #: Hawthorne Lot 119 Septic Permit #: 7698
Zoning Permit #: 18071 Environmental Health Specialist: David Cumber

This well permit is to locate and site the area that a private groundwater well may be established on the property listed above by the Environmental Health Specialists of Granville County. If one does not locate the well in the approved area and complete the well as specified by the 15A NCAC .02C rules, then permits may be revoked. At completion of drilling of the well, grout must be witnessed by EHS and a well log turned into Environmental Health.

Minimum Setbacks: (these are the main setbacks, but not all required setbacks)

Setback from property lines – 10 ft Setback from septic tank and drain field, including repair area – 100 ft
Setback from structural foundations – 25 ft Setback from ponds, lakes or other bodies of water – 50 ft

Site Sketch:

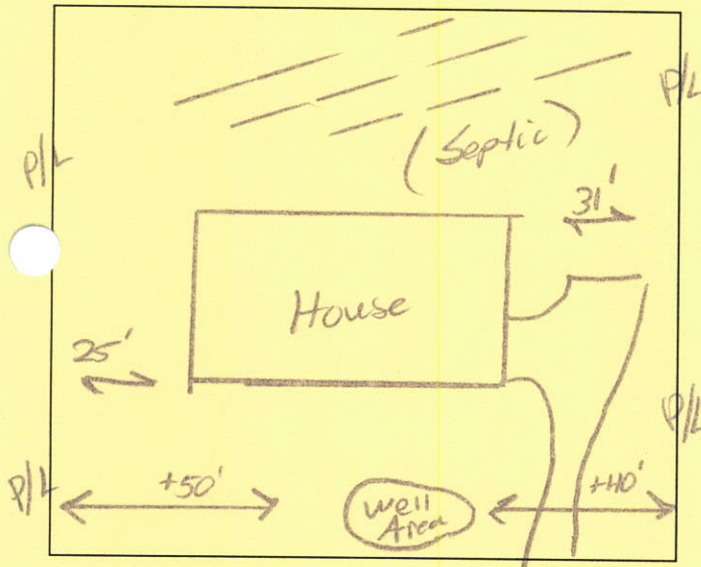

Conditions: Call 919-693-2688
w/ questions

Authorized Agent: David Cumber
Date: 12/4/13

1 Well Grout: (Circle or write in)

Witnessed: Yes or No EHS Agent: David Cumber
Date: 12-1-14 Annular Space Open: Yes or No
Over reamed: Yes or No Depth Grouted: 20'
Method: Pump ☒ Poured ☐ Pressure ☐
Well Log received: Yes or No (EHS to Attach to Permit)
Driller Name: _____ Cert. # _____

Depth: 660' Casing Depth: 119' GPM: 3
Restante - 10 bags

2 Well Final: (Place a check mark when finalized)

Seal Present and Intact: ☒ Air Vent: ☒
Hose Spigot: ☒ Electrical Box: ☒
Pump Installer Tag: ☒ Well Installer Tag: ☒
All holes sealed: ☒ 12" above grade: ☒

Comments: _____

3 Well Completion Permit: David Cumber EHS
Date Completed: 3-18-15

4 Water Samples Taken: Date: 3-23-15
EHS: DC Results: _____
Retest: _____ Results: _____

As Built Drawing:

