

GRANVILLE VANCE

public health

IMPROVEMENT PERMIT

Granville County Health Dept
Environmental Health
101 Hunt Drive
Oxford, NC 27565
Phone: (252) 492-5263 Fax: (252) 492-2361

For Office Use Only

*CDP File Number 362342
County ID Number: 191500196784
Evaluated For: NEW

PERMIT VALID UNTIL: 09/01/2026

***NOTE TO INSPECTIONS DIVISION:** Building Permits cannot be issued with this Improvement Permit.

Applicant: Carolina Custom Homes of Burlington
Address: 2450 N. Church St
City: Burlington
State/Zip: NC 27217
Phone #: home: (336) 226-9066
cell: (336) 226-9066

Property Owner: Carlos & Yolanda Ector
Address: 5605 Country Club Rd
City: Greensboro
State/Zip: NC. 27406
Phone #: 336 226 9066

Property Location & Site Information

Address/Road #: 3014 Splitwood Ct Oxford, NC 27565 Subdivision: Bent Tree Phase: NEW Lot: 41
Structure: SINGLE FAMILY
of Bedrooms: 3
of People:
*Water Supply: NEW WELL

System Specifications

Initial System

*Site Classification: Provisionally Suitable
Design Flow: 360
Soil Application Rate: 0.3000

Minimum Trench Depth: 18 Inches
Maximum Trench Depth: 20 Inches

*System Classification/Description:
TYPE III B. SYSTEM W/SINGLE EFFLUENT PUMP

Septic Tank: 1000 Gallons
Pump Required ☒ Yes ☐ No ☐ May Be Required
Pump Tank: 1000 Gallons

*Proposed System:
25% REDUCTION

Repair System Required: ☒ Yes ☐ No ☐ No, but has Available Space

pump fee paid 5-12-22

Repair System

*Site Classification: Provisionally Suitable
Soil Application Rate: 0.300

Minimum Trench Depth: 18 Inches
Maximum Trench Depth: 20 Inches

*System Classification/Description:
TYPE III B. SYSTEM W/SINGLE EFFLUENT PUMP

Pump Required: ☒ Yes ☐ No ☐ May Be Required

*Proposed System:
25% REDUCTION

Pump Tank: 1000 Gallons

No grading or construction activity is allowed in areas designated for system and repair without approval of Health Department

*Site Modifications

The issuance of this permit by the Health Department in no way guarantees the issuance of other permits. The permit holder is responsible for checking with appropriate governing bodies in meeting their requirements.

*Permit Conditions

* Installer Note: trenches should be 18" - 20" (22" MAX if needed to achieve grade. No out crops or boulders but rocks present.

The Department and Local Health Department may impose conditions on the issuance and may revoke the permits for failure of a system to satisfy the conditions, the rules, or this article. This permit is subject to revocation if the site plan, plat, or intended use changes (NCGS 130A-335(f)). The person owning or controlling the system location, installing, operation, maintenance, monitoring, reporting, and repair (1938(b)).

Authorized State Agent: Stiles, Bailey

Stiles, Bailey

Date of Issue: 09/01/2021

Total Time: (HH:MM)

☒ Hand Drawing

☐ Import Drawing

****Site Plan/Drawing attached.****

Granville - Vance District Health Department
Environmental Health

P-362342

Pin 1915001916784

Permit Number S-251161
W-252203


Final Sketch

Carolina Custom Homes of Burlington
Applicants Name

Bent Tree - #41
Subdivision - Section - Lot

Physical Address: 3014 Splitwood Ct Number of Bedrooms 3

Chambers Backhoe + Grading System Installer Date 05-12-2022

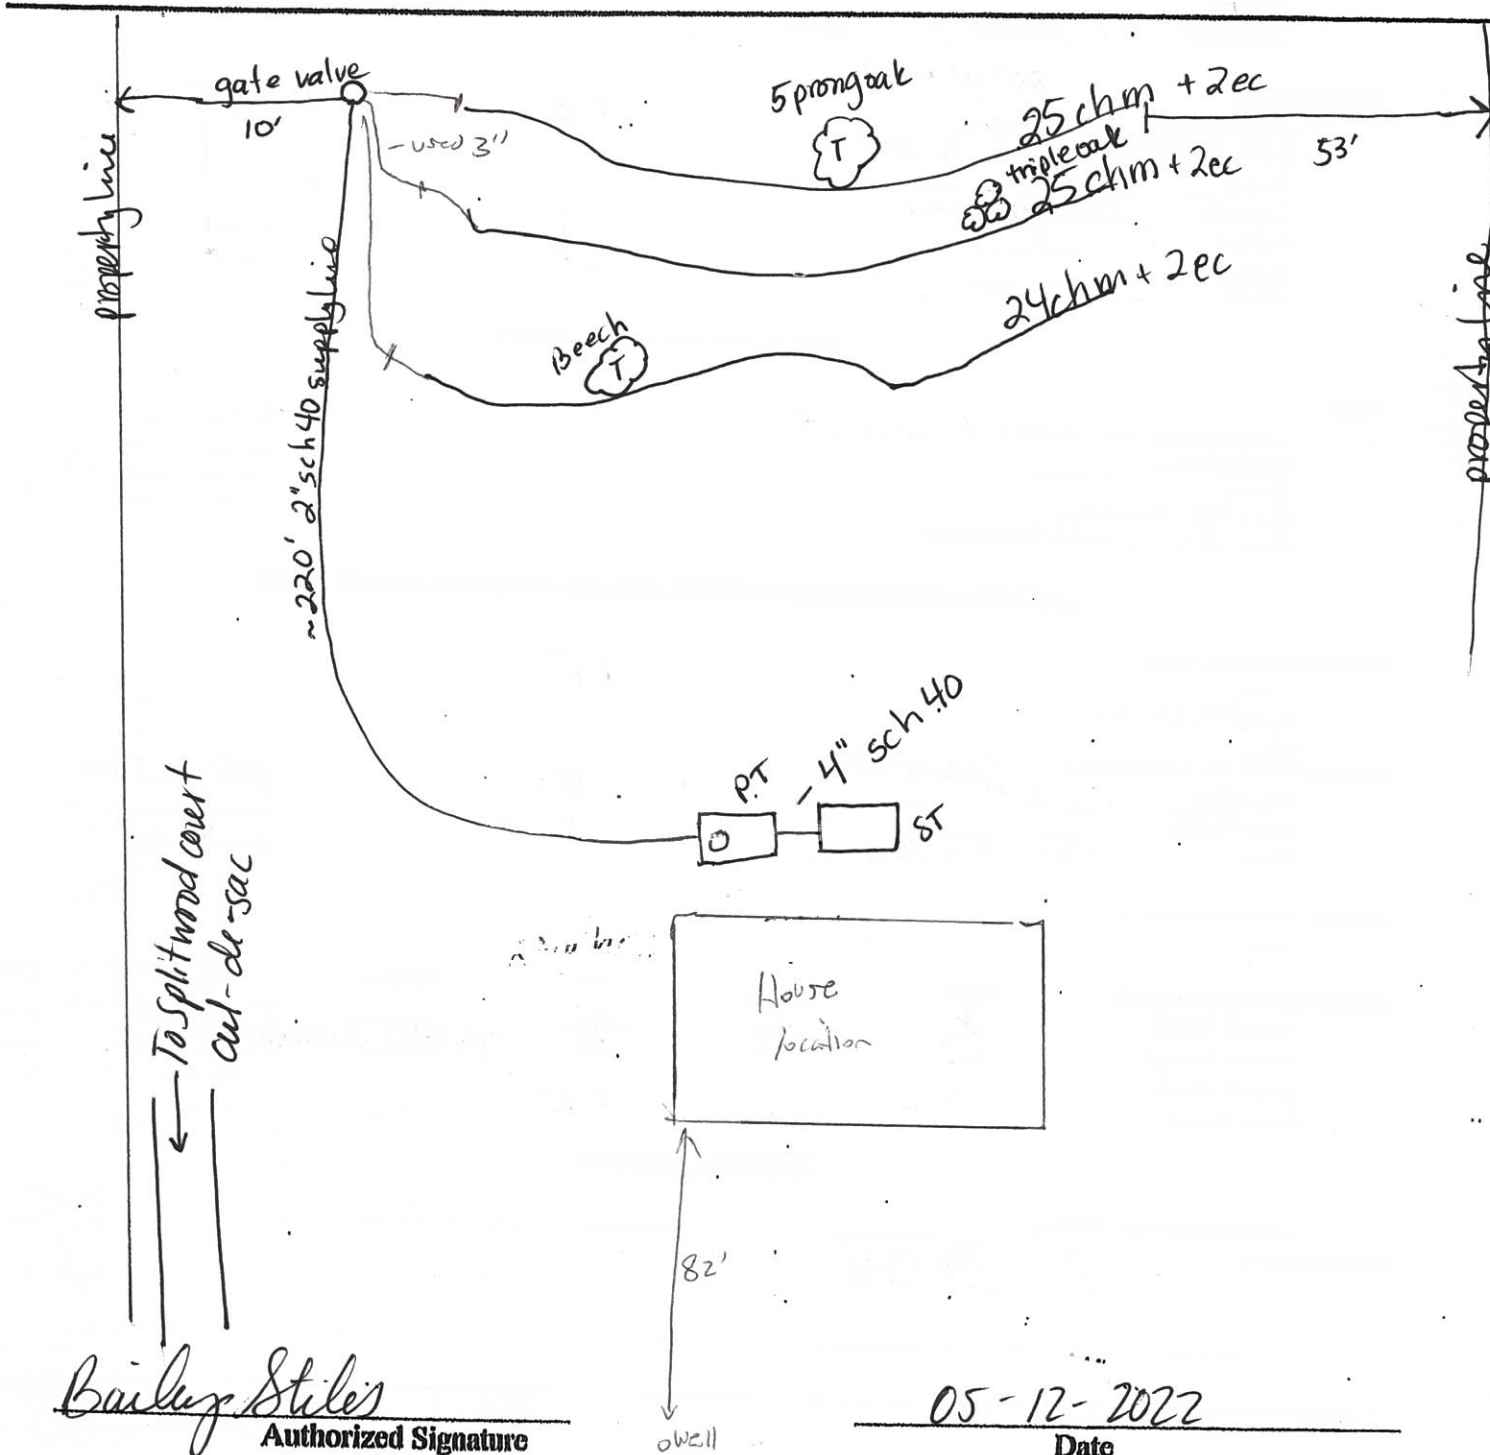

Bailey Stiles
Authorized Signature

05-12-2022
Date



Well Construction Permit

Granville County Health Dept
Environmental Health
101 Hunt Drive
Oxford NC, 27565
Phone: (252) 492-5263 Fax: (252) 492-2361

For Office Use Only

*CDP File Number 362342

PIN Number: 191500196784

Tax Lot #: 41

Tax Block #: _____

Evaluated For: SINGLE FAMILY \ WELL

Property Owner: Carlos & Yolanda Ector

Address: 5605 Country Club Rd

City: Greensboro

State/Zip: NC / 27406

Phone #: _____

Applicant: Carolina Custom Homes of Burlington

Address: 2450 N. Church St

City: Burlington

State/Zip: NC / 27217

Phone #: _____

Property Location & Site Information

Address/Road #:

Subdivision:

Bent Tree

Phase: _____

Lot: _____

41

3014 Splitwood Ct

Oxford NC, 27565

*Proposed use of Well: SINGLE FAMILY

Directions

If Other: _____

Well Contractor Information

Drilling Contractor: _____

Driller Registration: _____

Permit Conditions

*Permit Conditions

See site sketch for well area. Driller to maintain all setbacks.

WG 11-28-22
well permit paid for 5-12-22

Well location, construction and protection must meet all state and local regulations and must be inspected and approved by an authorized representative of the Local Health Department. The permit may be revoked at any time for failure to comply with existing regulations. The siting of approved well construction area(s) by the Health Department is to provide protection from the known possible sources of contamination. The approved well area(s) may not be changed without permission from an authorized representative of the Local Health Department. No volume of quality of water is guaranteed by the Health Department.

*Issued By: Stiles, Bailey

Authorized State Agent: _____

Owner/Applicant: _____

*Date of Issue: 09/01/2021



Hand Drawing



Import Drawing

****Site Plan/Drawing attached.****