



IMPROVEMENT PERMIT

Granville County Health Dept
Environmental Health
101 Hunt Drive
Oxford, NC 27565
Phone: (252) 492-5263 Fax: (252) 492-2361

For Office Use Only

*CDP File Number 418650 - 1
County ID Number: _____
Evaluated For: NEW

PERMIT VALID UNTIL: 11/14/2029

***NOTE TO INSPECTIONS DIVISION:** Building Permits cannot be issued with this Improvement Permit.

Applicant: Wes Springob
Address: 7308 River Glen Court
City: Raleigh
State/Zip: NC 27614
Phone #: home: (727) 244-0857 cell : (727) 244-0857

Property Owner: Wes Springob
Address: 2665 Bodie Currin Rd
City: Oxford
State/Zip: NC. 27565
Phone #: home: (727) 244-0857 cell : (727) 244-0857

Property Location & Site Information

Address: 2665 Bodie Currin Rd Oxford, NC 27565 Subdivision: _____ Block/Phase: NEW Lot: _____

Directions

Road #: _____
Structure: MOBILE HOME
of Bedrooms: _____
of People: _____
*Water Supply: NEW WELL

System Specifications

Initial System

Usable Soil Depth: 30
Design Flow: 240
Soil Application Rate: 0.3000

Minimum Trench Depth: 16 Inches
Maximum Trench Depth: 16 Inches

*System Classification/Description:
TYPE III B. SYSTEM W/SINGLE EFFLUENT PUMP

Septic Tank: 1000 Gallons
Pump Required ☐ Yes ☐ No ☒ May Be Required

*Proposed System:
25% REDUCTION

Pump Tank: 1000 Gallons

Repair System Required: ☒ Yes ☐ No ☐ No, but has Available Space

Repair System

Usable Soil Depth: 28
Soil Application Rate: 0.300

Minimum Trench Depth: 14 Inches
Maximum Trench: Depth: 14 Inches

*System Classification/Description:
TYPE III B. SYSTEM W/SINGLE EFFLUENT PUMP

Pump Required: ☒ Yes ☐ No ☐ May Be Required

*Proposed System: 25% REDUCTION

Pump Tank: _____ Gallons

No grading or construction activity is allowed in areas designated for system and repair without approval of Health Department.

*Site Modifications

The issuance of this permit by the Health Department in no way guarantees the issuance of other permits. The permit holder is responsible for checking with appropriate governing bodies in meeting their requirements.

*Permit Conditions

Refer to LSS for septic layout and well location.



Construction Authorization

Granville County Health Dept
Environmental Health
101 Hunt Drive
Oxford, NC 27565
Phone: (252) 492-5263 Fax: (252) 492-2361

For Office Use Only

*CDP File Number: 418650 - 1

County ID Number:

Evaluated For: NEW

PERMIT VALID UNTIL: 11/14/2029

☐ Open Pump System Sheet

Applicant: Wes Springob
Address: 7308 River Glen Court
City: Raleigh
State/Zip: NC 27614
Phone #: home: (727) 244-0857 cell: (727) 244-0857

Property Owner: Wes Springob
Address: 2665 Bodie Currin Rd
City: Oxford
State/Zip: NC, 27565
Phone #: home: (727) 244-0857 cell: (727) 244-0857

Property Location & Site Information

Address/Road #: 2665 Bodie Currin Rd Oxford, NC 27565 Subdivision: _____ Phase: NEW Lot: _____
Structure: MOBILE HOME **Directions:** _____
of Bedrooms: 2
of People: _____
*Water Supply: NEW WELL

System Specifications

Usable Soil Depth: 30 Minimum Trench Depth: 16 Inches
Design Flow: 240 Maximum Trench Depth: 16 Inches
Soil Application Rate: 0.3000 Minimum Soil Cover: 4 Inches
*System Classification/Description: TYPE III B. SYSTEM W/SINGLE EFFLUENT PUMP Maximum Soil Cover: 6 Inches
*Proposed System: 25% REDUCTION *Distribution Type: PRESSURE MANIFOLD
Nitrification Field: 600 Sq. ft. Septic Tank: 1,000 Gallons
No. Drain Lines: 2 Pump Required: ☐ Yes ☐ No ☒ May Be Required
Total Trench Length: 200 ft. ☐ Inches O.C. Pump Tank: 1,000 Gallons
Trench Spacing: 9 - ☒ Feet O.C. Grease Trap: Gallons
Trench Width: 3 - ☐ Inches
Aggregate Depth: inches ☒ Feet Septic Tank Installer
Grade Level Required: ☐ I ☐ II ☐ III ☐ IV

The issuance of this permit by the Health Department in no way guarantees the issuance of other permits. The permit holder is responsible for checking with appropriate governing bodies in meeting their requirements.

*Permit Conditions:

Refer to LSS for septic layout. Keep all parts of septic 50ft min. from any wells. Keep all parts of septic 10ft min. from property lines. Keep all parts of septic 5ft min. from house. Approved cover soil. May be enough from trenches.

The Authorization for Wastewater System Construction shall be valid for a period equal to the period of validity of the Improvement Permit and may be issued at the same time the Improvement Permit issued (NCGS 130A-336(b)). If the installation has not been completed during the period of validity of the Construction Permit, the information submitted in the application for a permit or Construction Authorization shall become invalid, and may be suspended or revoked (.0204(k)(1)). The person owning or controlling the system shall be responsible for assuring compliance with the laws, rules, and permit conditions regarding system location, installation, operation, maintenance, monitoring, reporting and repair (per rule .0301(a)).

Authorized State Agent: Wilkerson, Austin Austin Wilkerson REHS

Date of Issue: 11/14/2024

LSS Drawing

☐ Hand Drawing ☐ Import Drawing

Site Plan/Drawing attached.

Total Time : (HH:MM) _____



Well Construction Permit

Granville County Health Dept
Environmental Health
101 Hunt Drive
Oxford NC, 27565
Phone: (252) 492-5263 Fax: (252) 492-2361

For Office Use Only

*CDP File Number 418650
PIN Number: _____
Tax Lot #: _____ Tax Block #: _____
Evaluated For: _____

PERMIT VALID UNTIL: 11/14/2029

Property Owner: Wes Springob
Address: 2665 Bodie Currin Rd
City: Oxford
State/Zip: NC / 27565
Phone #: H: (727) 244-0857 C: (727) 244-0857

Applicant: Wes Springob
Address: 7308 River Glen Court
City: Raleigh
State/Zip: NC / 27614
Phone #: H: (727) 244-0857 C: (727) 244-0857

Property Location & Site Information

Address/Road #: 2665 Bodie Currin Rd Subdivision: _____ Phase: _____ Lot: _____
Oxford NC, 27565
*Proposed use of Well: _____
If Other: _____
Applicant Email: springob@gmail.com
Owner Email: springob@gmail.com

Directions:

Well Contractor Information

Drilling Contractor: _____ Driller Registration: _____

Permit Conditions

*Permit Conditions

Keep proposed well 50ft min. from any proposed septic or septic area. Keep proposed well 25ft min. from house location.
Keep well out of overhead power right of way and road right of way. Refer to documents provided about contaminated location found within 1000ft radius of property.

Well location, construction and protection must meet all state and local regulations and must be inspected and approved by an authorized representative of the Local Health Department. The permit may be revoked at any time for failure to comply with existing regulations. The siting of approved well construction area(s) by the Health Department is to provide protection from the known possible sources of contamination. The approved well area(s) may not be changed without permission from an authorized representative of the Local Health Department. Issuance of this well permit does not guarantee water quality or adequate water production from the well once it is installed or repaired.


*Issued By: Wilkerson, Austin
Authorized State Agent: Austin Wilkerson REHS
Owner/Applicant: Wes Springob

*Date of Issue: 11/14/2024
☐ Hand Drawing ☐ Import Drawing

****Site Plan/Drawing attached.****

ALSS Drawing

Granville County, NC

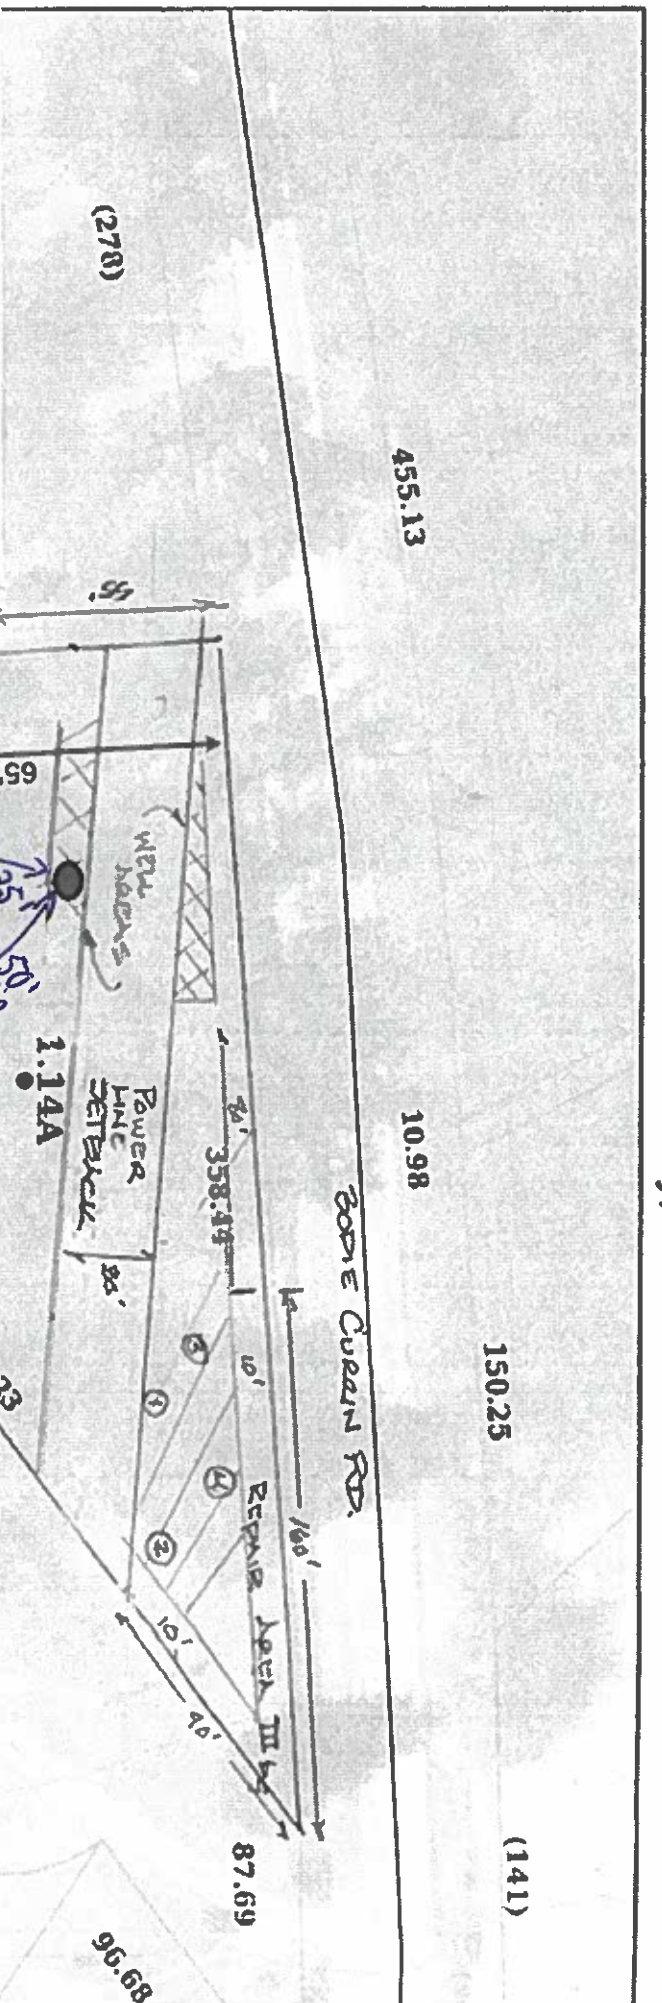

LSS Evaluation/Site Plan
Q.S. 1304-338(e2) Submittal

For: A&W of Raleigh
7308 River Glen Ct.
Raleigh, NC 27614
WHS@AMMO-Baldrige.com
(727) 244-0857

Site: 2668 Bodie Curtin Road
Oxford, NC 27565
Parcel #: 190402779641
Granville County, NC

Notes:
Soil borings numbered and marked with orange flagging
Corners of proposed drain field marked with yellow flagging
Proposed drain lines flagged by GCHD (orange and yellow)
Locations and distances are approximate

Soil/System:
Design soil depth: 30"
LIR= 0.3 GPD/FT²
4% slope/ 16" maximum downslope trench depth
Two-bedroom system = 240 GPD
Soil type: Accepted/IIIg or IIIbg (200 Lb Ft.)

Plan Scale: 1" = 60'



Harold Kelly
NC Licensed Soil Scientist/ CPSS
7309 Blalock Road
Bahama, NC 27503
(336) 322-4724 office
(336) 598-2382 cell
hkelly0501@gmail.com




WPDT Screening Report

Area of Interest (AOI) Information

Area : 3,221,221.92 ft²

Nov 14 2024 11:53:18 Eastern Standard Time

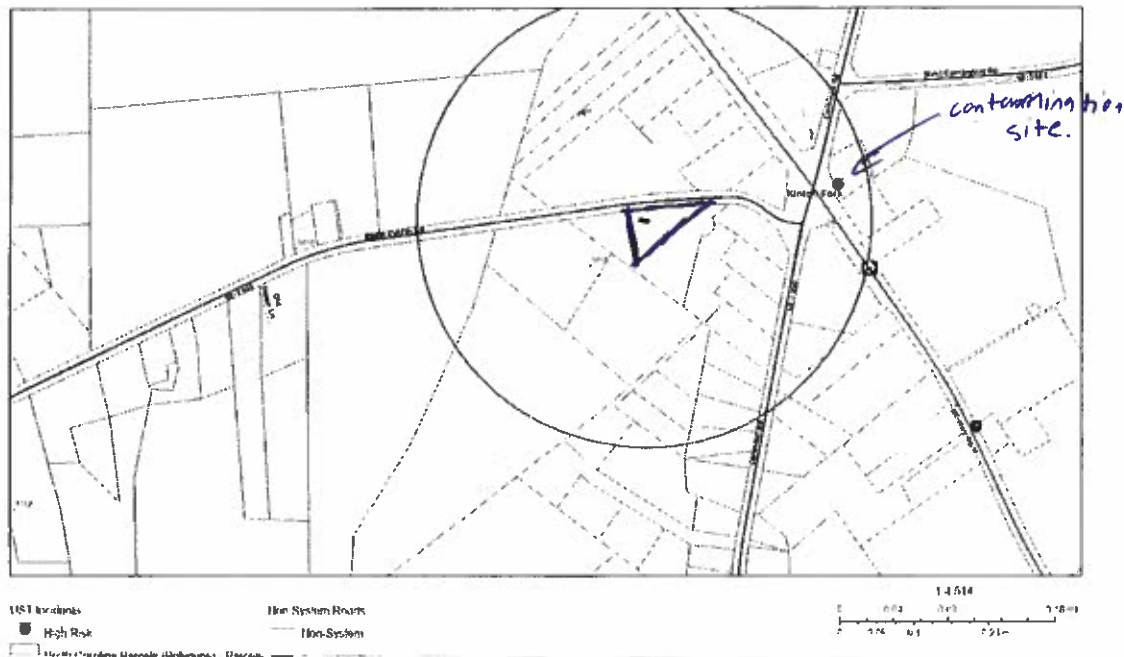

UST Incidents

#	IncidentNumber	IncidentName	Address	CityTown	DateReported	Count
1	12604	STOVALL COUNTRY STORE	6192 Hwy 96 North	OXFORD	3/11/1994, 7:00 PM	1

All North Carolina Department of Environmental Quality (NCDEQ) GIS data is expressly provided "AS IS" and "WITH ALL FAULTS". The NCDEQ makes no warranty of any kind, express or implied, concerning this information, including but not limited to any warranties of merchantability or fitness for any particular purpose. The NCDEQ assumes no responsibility or legal liability concerning the Data's accuracy, reliability, completeness, timeliness, or usefulness. The data is not intended to constitute advice nor is it to be used as a substitute for specific advice from a professional. Users should not act (or refrain from acting) based upon information in the Data without independently verifying the information and obtaining any necessary professional advice. Users are solely responsible for ensuring the accuracy, currency and other qualities of any products derived from or in connection with the NCDEQ's Data. The Data is collected from various sources and may be modified over time without notice to improve spatial and attribute accuracy. The NCDEQ disclaims responsibility for the spatial accuracy and attribution of GIS features and makes no warranty concerning same.

UST Section

Incident # 12604

Description of Dataset

The Underground Storage Tank (UST) Section's data presented here is representative of two different programs within the Section; the UST program and the Aboveground Storage Tank/Non-UST (AST) program. While the UST data relates only to releases of regulated substances from UST systems, the AST data may be related to a variety of release sources, such as AST systems, fuel tanker spills, illegal dumping, etc. All UST Section features presented in this tool represent locations where the latest reports document confirmed or assumed exceedance(s) of the NC Groundwater Quality Standard and/or the Soil-to-Groundwater Maximum Soil Contaminant Concentrations (MSCCs).

Contaminants Potentially Present

UST and AST Program Sampling Recommendations:

- Volatile Organic Compounds
- Semivolatile Organic Compounds
- Metals (Cr and Pb)

Contact Information

To request additional information from the UST Section please contact the NCDEQ Regional Office assigned to the area of interest and ask to speak with a member of the UST Section. A map of the UST Section's Regional Office coverage areas and phone numbers can be viewed by following this [link](#). The UST Section's Regional Office contact information is also presented below.

UST Section - Regional Office Contact Information

Asheville (ARO) – 2090 US Highway 70, Swannanoa, NC 28778 **(828) 296-4500**

Fayetteville (FAY) – 225 Green Street, Suite 714, Systel Building, Fayetteville, NC 28301 **(910) 433-3300**

Mooreville (MOR) – 610 East Center Avenue, Suite 301, Mooreville, NC 28115 **(704) 663-1699**

Raleigh (RRO) – 1628 Mail Service Center, Raleigh, NC 27699 **(919) 791-4200**

Washington (WAS) – 943 Washington Square Mall, Washington, NC 27889 **(252) 946-6481**

Wilmington (WIL) – 127 Cardinal Drive Extension, Wilmington, NC 28405 **(910) 796-7215**

Winston-Salem (WS) – 450 West Hanes Mill Road, Suite 300, Winston-Salem, NC 27105, **(336) 776-9800**

Guilford County Environmental Health, 400 West Market Street, Suite 300, Greensboro, NC 27401, **(336) 641-3771**