

Robert 2:00

PERMIT NUMBER 4352

GRANVILLE-VANCE DISTRICT HEALTH DEPARTMENT
IMPROVEMENT AND OPERATION PERMITS

COUNTY:	TAX NO.	TYPE OF ESTABLISHMENT			*THIS PERMIT SHALL BE ACCOMPANIED BY A LAYOUT SHOWN ON A PLAT, INCLUDING SYSTEM REQUIREMENTS.
Granville	182800836388				
	SR. NO. 1622	RESIDENCE ☒	NUMBER OF BEDROOMS: 3	NUMBER OF OCCUPANTS: 3 per.	
OWNER:	Shane Mitchell				
APPLICANT:	Nancy Wynn				*THE IMPROVEMENTS PERMIT MUST BE ATTACHED TO A CONSTRUCTION AUTHORIZATION BEFORE OBTAINING BUILDING PERMIT OR OTHER CONSTRUCTION PERMITS AND BEFORE A WASTEWATER SYSTEM IS INSTALLED. *THIS IMPROVEMENT PERMIT IS SUBJECT TO REVOCATION IF THE INTENDED USES CHANGE FROM THOSE SHOWN ON THE IMPROVEMENT PERMIT. CHANGES SHALL REQUIRE HEALTH DEPARTMENT APPROVAL.
APPLICANT'S ADDRESS:	WATER SUPPLY				
1696 Hayes Rd. Circummar	PUBLIC	WELL ☒	OTHER		
PROPERTY ADDRESS/LOCATION:	TYPE OF WASTEWATER SYSTEM				
27522 Ridgewood Drive off Canady Mill Rd.	DESCRIPTION	INITIAL INSTALLATION	REPAIR		
SUBDIVISION:	DESIGN FLOW:	360 gal/day			
LOT NUMBER:	LTAR:	3 gal/day/ft			
24	ABSORPTION AREA:	1200 ft ²			
REFERENCE SKETCH (SEE PLAT FOR DETAILS)	TRENCH WIDTH:	3'			
* See attached sheet for layout	TRENCH SPACING:	9' o.c.			
Lines dug level and on contour with trench depth 18"-24"	TOTAL TRENCH LENGTH:	400'	300'		
Stay 10' from property line, 10'-15' from foundation drain	NUMBER OF TRENCHES:	3	3		
	GRAVEL DEPTH:	12"	EZ Flow		
	TANK SIZE:	1000 gal + D-Box			
	CONDITIONS:	* See Authorization & Construction			
IMPROVEMENT PERMIT			DATE:		PERMIT VALID FOR 5 YEARS FROM DATE OF ISSUE
FOR:	Shane Mitchell, Nancy Wynn		8-23-04		
ISSUED BY:	Daryl Cumba				
OPERATION PERMIT			DATE:		
SYSTEM INSTALLED BY:	Robert Blackley		11-29-04		
ISSUED BY:	M.E. Young, RS				

GRANVILLE-VANCE HEALTH DEPARTMENT—Sewage Disposal Record

Owner or Contractor Shane Mitchell/Nancy Wynn Date 11-29-04 S.R. No. 1622
 Location/Address Ridgewood Drive off Cannady Mill Rd.
 Subdivision/Mobile Home Park Name Ridgewood Lot Size 1.017 acres
 Permit No. # 4352 Lot No. 24

New System ☒ Repair _____
 House ☒ Mobile Home _____ Business _____
 No. Bedrooms 3 No. People _____ No. Toilets _____
 Water Supply: Private ☒ Approved _____
 Semi-Public _____ Unapproved _____
 Public _____ None _____

Nitrification System:

Tank Size 1000 gal.
 Distribution Box ☒ No. Lines 3
 Nitrification Field 1200 Sq. Ft.

Lines:	1	2	3	4	5	6
Width	<u>3'</u>	<u>3'</u>	<u>3'</u>			
Length	<u>100'</u>	<u>100'</u>	<u>100'</u>			
Grade	<u>0'</u>	<u>0'</u>	<u>0'</u>			

Stone Depth 10 10 10 _____


Layout to be followed by installer:

E2 Flow unit

Improvements Permit By David Cuybee Installer Robert Blackley
 Certificate of Completion By Eddie Yount Date of Inspection 11-29-04

* Construction must comply with all other applicable state and local regulations, but the permit is not a guarantee that the system will not malfunction and the Granville-Vance Health District will not be held responsible for a malfunctioning system.

NOTE: Make sketch of installation showing location of house, septic tanks, privies, water supplies on adjacent property, etc. Write in measurements in order that installations may be located at later date.

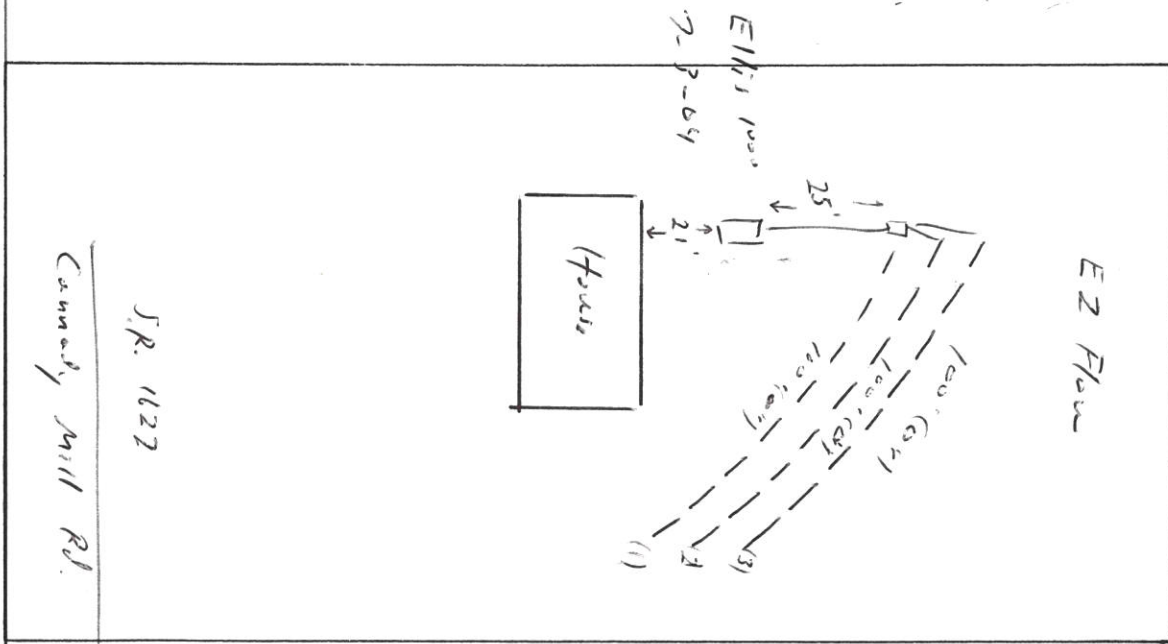

J.R. 1622

Cannedy Mill Rd.

Ridgewood Drive