

252-478-4644

FRANKLIN COUNTY HEALTH DEPARTMENT

PERMIT NUMBER: 16566C CONST IMPROVE PERMIT 20020607	DATE: 2910-13-6543	SIZE: 59.700
APPLICANT: BRANCH ODELL PO BOX 28 LOUISBURG NC 27549 TELEPHONE: 496-6808	OWNER: BRANCH THOMAS W	
COMMENT:	DESCRIPTION: 5 YEAR ☐	LIFETIME: ☐
LOCATION / DIRECTIONS:		
FEE: OPIE FRAZIER RD 175.00	SIGNATURE OR OWNER OR AUTHORIZED AGENT:	

THE ABOVE SIGNATURE INDICATES THAT I HAVE READ, UNDERSTAND, AND AGREE WITH ALL PROVISIONS AND INFORMATION AS OUTLINED ON THE BACK SIDE OF THIS FORM

TOPO <u>S</u>	TEXTURE <u>PS</u>	STRUCTURE <u>PS</u>	DEPTH <u>PS</u>
R. HOR <u>S</u>	SOIL. WET <u>S</u>	AVAIL. SP <u>S</u>	OTHER <u>-</u>
MINRL <u>SEXP</u>	OVERALL <u>PS</u>	LTAR <u>.4</u>	
#BEDRMS <u>3</u>	GPD <u>360</u>	DISPOSAL <u>-</u>	TYPE. SYS <u>CONV</u>
SZ. TANK <u>900</u>	SZ. CHAMB <u>-</u>	NITRIFI <u>3' X 300'</u>	TYPE. WAT <u>well</u>
SITE. LOC <u>-</u>	MAX TRENCH DEP <u>30"</u>	TYP. FAC <u>SFD</u>	

REMARKS:

* Drawing not to scale
 * Maintain set backs (foundation 5', well 50', property lines 10')


CONTRACTOR: David Brantley & SonsTANK MANUF: D-B 1000MANUF DATE: 9/23/02

* Must properly abandon old well and septic tank before system can be authorized

* Septic Contractor to establish and follow contour.

225' Panels

✓ 1" Lines & Tank
 10/18/02
 (Weed letter)
 on Tank

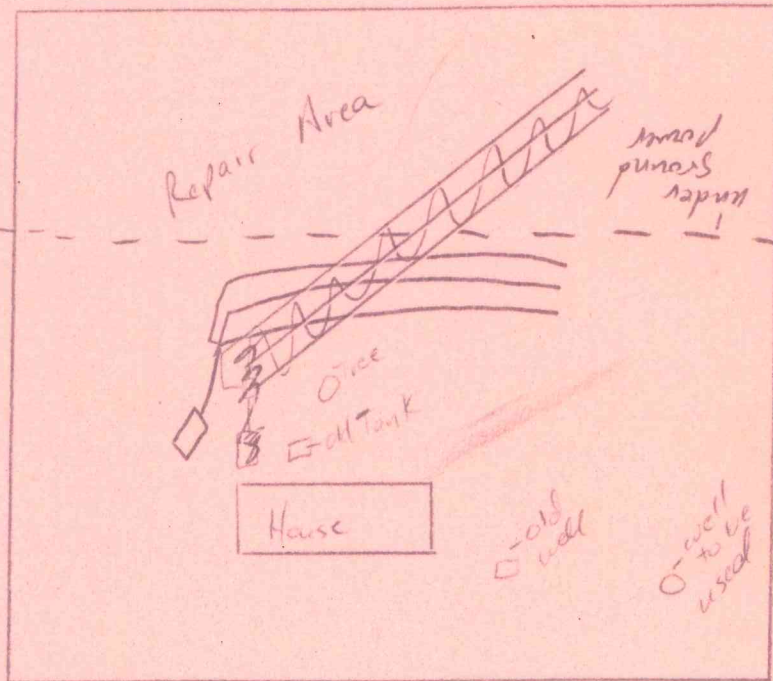

↓
 Opie Frazier Rd

IMPROVEMENT PERMIT DATE: 6/18/02ENV HEALTH SPEC: [Signature]CONSTRUCTION AUTHORIZATION DATE: 6/18/02ENV HEALTH SPEC: [Signature]