

PERMIT NUMBER 8157

GRANVILLE-VANCE DISTRICT HEALTH DEPARTMENT IMPROVEMENT AND OPERATION PERMITS

Zoning #
18591

COUNTY:	TAX NO.	TYPE OF ESTABLISHMENTS			*THIS PERMIT SHALL BE ACCOMPANIED BY A LAYOUT SHOWN ON A PLAT, INCLUDING SYSTEM REQUIREMENTS.
Granville	SR. NO.	RESIDENCE ☒	NUMBER OF BEDROOMS:	NUMBER OF OCCUPANTS:	
		BUSINESS ☐	3	6 max	
		OTHER ☐			
OWNER:		WATER SUPPLY	WELL ☒	OTHER ☐	*THIS IMPROVEMENT PERMIT IS SUBJECT TO REVOCATION IF THE INTENDED USES CHANGE FROM THOSE SHOWN ON THE IMPROVEMENT PERMIT. CHANGES SHALL REQUIRE HEALTH DEPARTMENT APPROVAL.
APPLICANT'S ADDRESS:		TYPE OF WASTEWATER SYSTEM	INITIAL INSTALLATION	REPAIR	
1203 Bayview Ct.			Type III g	Type III b y	
Franklin, 27525		DESIGN FLOW:	360 gpd		
PROPERTY ADDRESS/LOCATION:		LTAR:	275 gpd / ft ²		
1210 Bayview Ct.		ABSORPTION AREA:	1309 ft ² → 982 ft ²		
SUBDIVISION:		TRENCH WIDTH:	3'		
13 Antley Place		TRENCH DEPTH:	24"		
LOT NUMBER:		TRENCH SPACING:	9' o.c.		
17		TOTAL TRENCH LENGTH:	340'		
REFERENCE SKETCH (SEE PLAT FOR DETAILS)		NUMBER OF TRENCHES:	4		PERMIT VALID FOR: 5 YEARS YES NO
- House must be 55' from R.W. as shown on site plan - Contours estimated - Call 919-693-2688 w/ questions		GRAVEL DEPTH:	Accepted Status		
		TANK SIZE:	1000 gal		
		PUMP TANK SIZE:			
		DISTRIBUTION DEVICE:	Distribution Box		
					NO EXPIRATION YES NO

IMPROVEMENT PERMIT

DATE:

3-13-15

FOR: Woodwright Builders

ISSUED BY: David Cohen

CONSTRUCTION AUTHORIZATION FOR IMPROVEMENT PERMIT# 8157

Unless otherwise indicated, the same conditions above apply regarding system type, layout, location and installation requirements.

(The wastewater system cannot be installed until authorization is signed)

Comments: Install in dry conditions

Date: 3-13-15 Environmental Health Specialist: David Cohen

Construction Authorization Addendum ☐ Yes ☐ No

OPERATION PERMIT

DATE:

12/8/16

SYSTEM INSTALLED BY:

ISSUED BY:

PERFORMANCE, MONITORING, MAINTENANCE AND OPERATION
AS REQUIRED BY RULE .1961

Granville – Vance District Health Department
Environmental Health

Final Sketch

Pin 182401981857

Improvement Permit

Construction Authorization

Wendy Blars
Applicant's Name

Permit No. 8657


Brantley Place 17
Subdivision – Section – Lot

Physical Address: 1210 Bayview Ct

David Truitt
System Installer

12/8/15
Date

System design and details as installed.

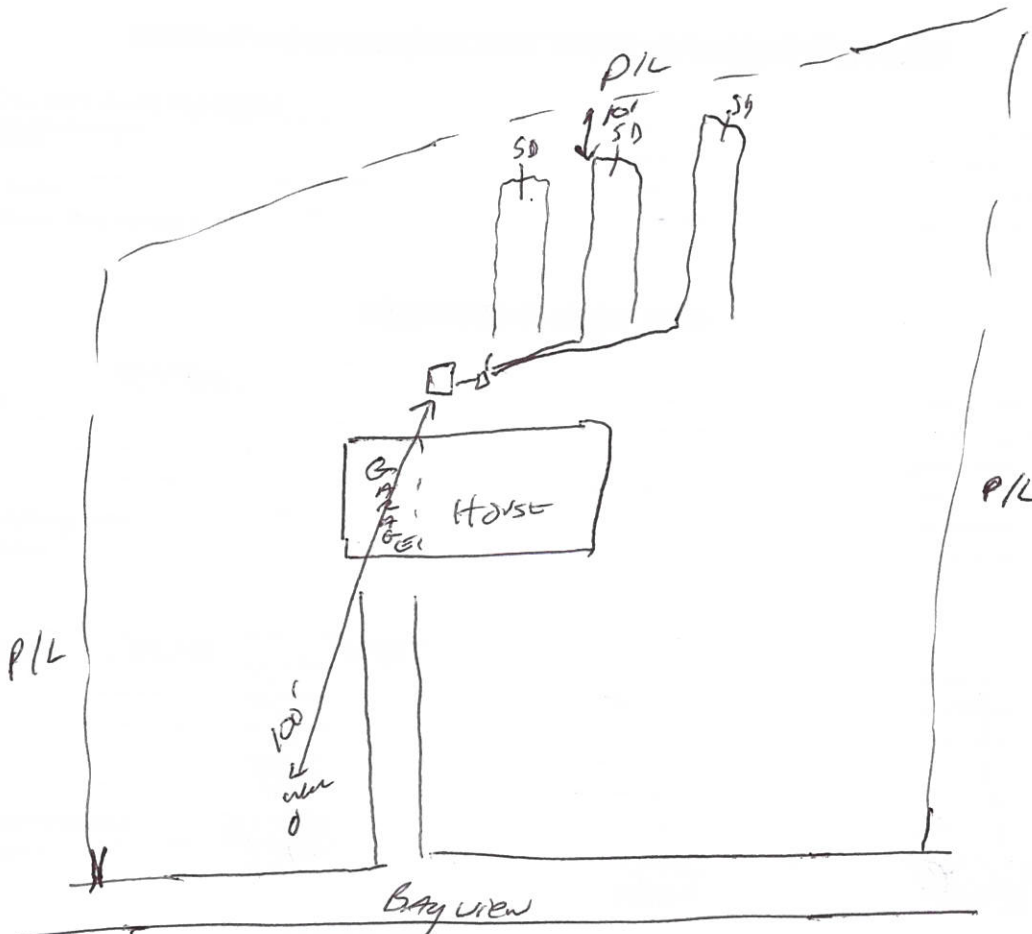

Chris Hall
Authorized Signature

12/8/15
Date