


KERR LAKE

U.S. CORPS LINE

PROPOSED
WELL SITE

NOT TO SCALE

SITE PLAN

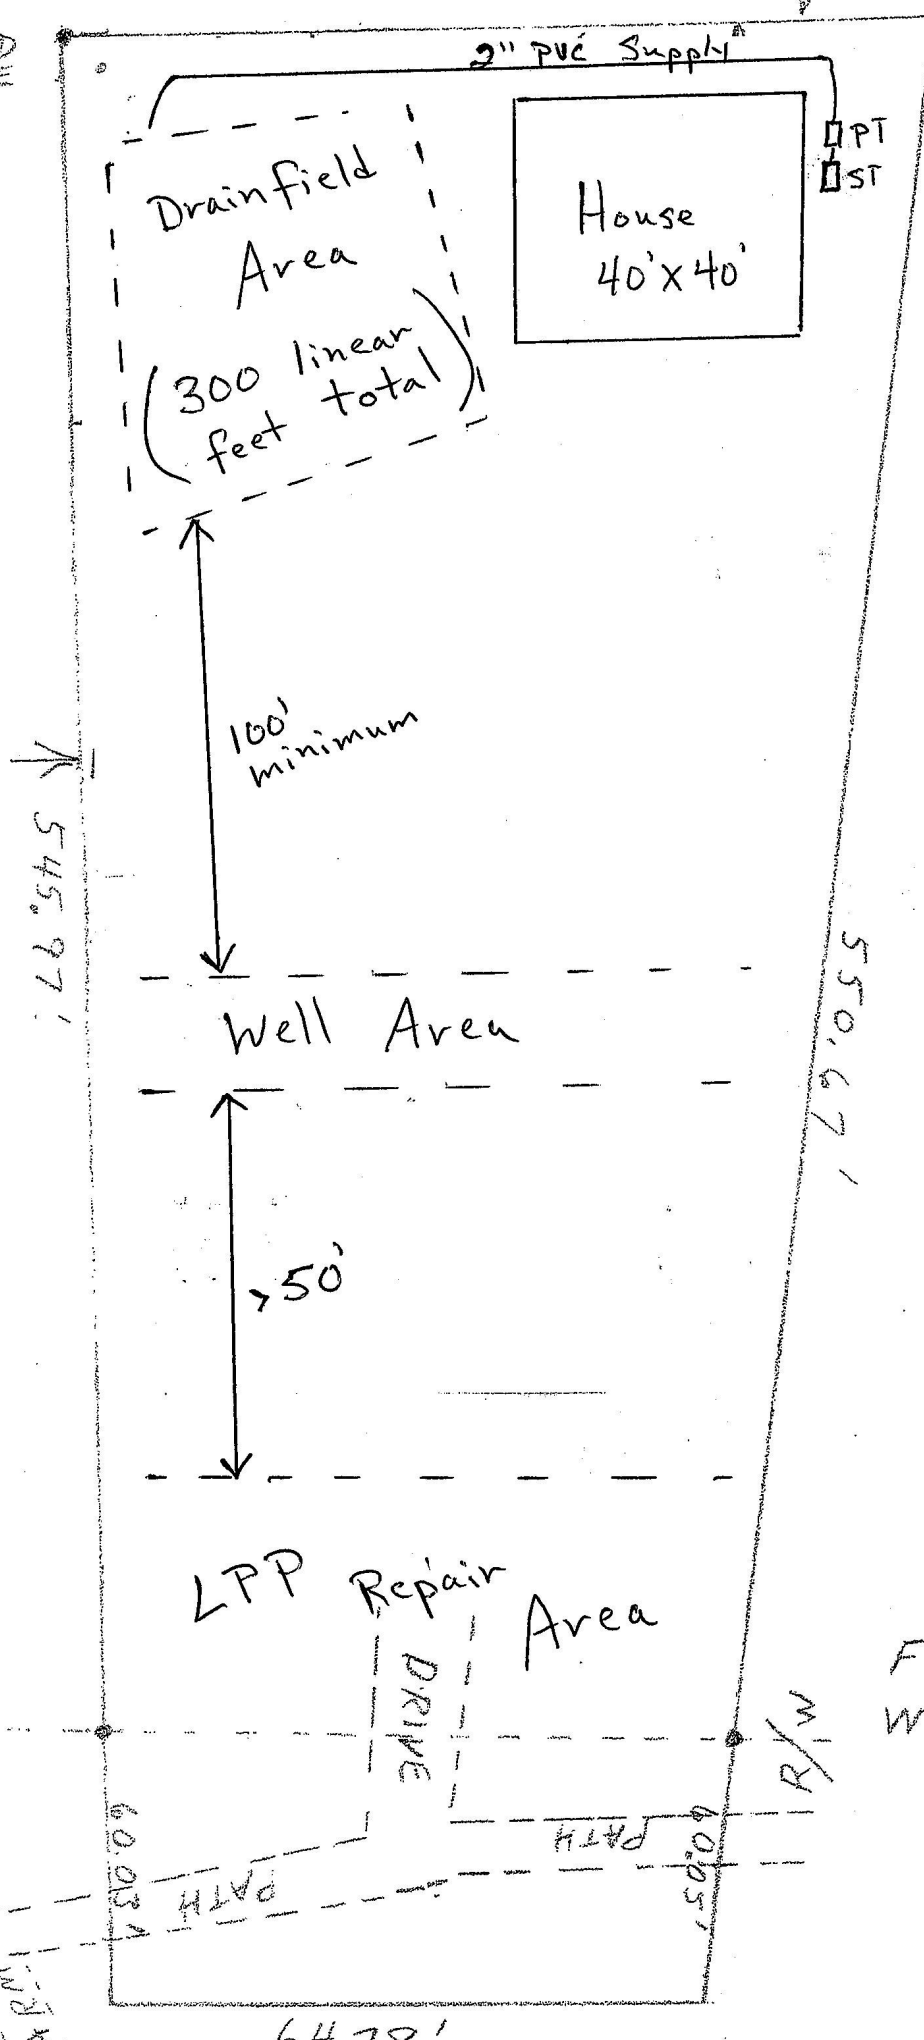

FRED H. ZEI
WENDY K. ZEI