

Granville - Vance District Health Department
Environmental Health

Pin 18350028366

Permit Number 6831

☒ Improvement Permit

☒ Construction Authorization

Final Sketch

Steven Hayes
Applicants Name

Montgomery Place #5
Subdivision - Section - Lot

Physical Address: Montgomery Place

David Brantley & Sons
System Installer

7-19-2010
Date

System design and details as installed.

Septic Tank Information:

Date: 5-12-09

Manufacture: D+B - 1000 gal

ID #: STB - 646

Pump Tank Information:

Date: 6-14-10

Manufacturer: DB

ID #: PT 237

Distribution Box

Pressure Manifold ☒

Serial Distribution ☐

Type of Facility: House

Number of Bedrooms: 3


Type of System: Pump - 2 Flow

zoeller N152-13 pump

Automated Control panel

2' pressure head set

± 150' TO prop. corner

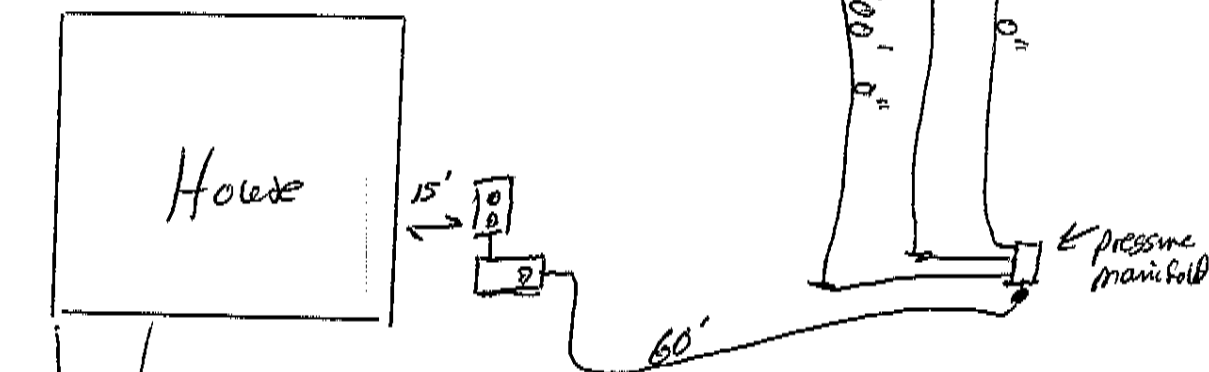

David Brantley
Authorized Signature

7-19-2010
Date