

OWNER Clayton Breedlove PERMIT # 405661 DATE 4/11/25
CONTRACTOR Clayton Breedlove WEATHER CONDITIONS Sunny
SOIL WETNESS Dry

SEPTIC AND PUMP TANK INSPECTION

SEPTIC TANK	INITIAL	DATE
Manufacturer _____	_____	_____
Date of Manufacture _____	_____	_____
Stamp _____	_____	_____
Capacity _____	_____	_____
Tee _____	_____	_____
Baffle _____	_____	_____
Sealant _____	_____	_____

Existing

PUMP TANK	INITIAL	DATE
Manufacture _____	_____	_____
Date of Manufacture _____	_____	_____
Stamp _____	_____	_____
Capacity _____	_____	_____
Sealant _____	_____	_____
Manhole _____	_____	_____
Draw Down Test _____	_____	_____

MECHANICAL INSPECTION

PUMP

Manufacturer and Model # _____	_____	_____
Control Panel _____	_____	_____
Alarm _____	_____	_____
Electrical Connection _____	_____	_____

NITRIFICATION/DISTRIBUTION AND DRAINFIELD INSPECTION

DISTRIBUTION BOX

Level _____	_____	_____
Equal Distribution _____	_____	_____
Other _____	_____	_____

DISTRIBUTION MANIFOLD

Pipe Size _____	_____	_____
Gate Valves _____	_____	_____
Other _____	_____	_____

OTHER DISTRIBUTION
Type _____

NITRIFICATION LINES	LINE 1	LINE 2	LINE 3	LINE 4	LINE 5	LINE 6
Trench Width	<u>135"</u>	<u>135"</u>	<u>3'</u>	_____	_____	_____
Trench Length	<u>Gravel</u>	<u>Gravel</u>	<u>100'</u>	_____	_____	_____
Trench Grade	<u>Existing</u>	<u>Existing</u>	<u>✓</u>	_____	_____	_____
Stone Depth	_____	_____	<u>Poly</u>	_____	_____	_____

COMMENTS:

405661

Granville - Vance District Health Department
Environmental Health


Final Sketch

Pin _____

Subdivision - Section - Lot _____

Physical Address: 7082 Cornwall Rd


System design and details as installed.

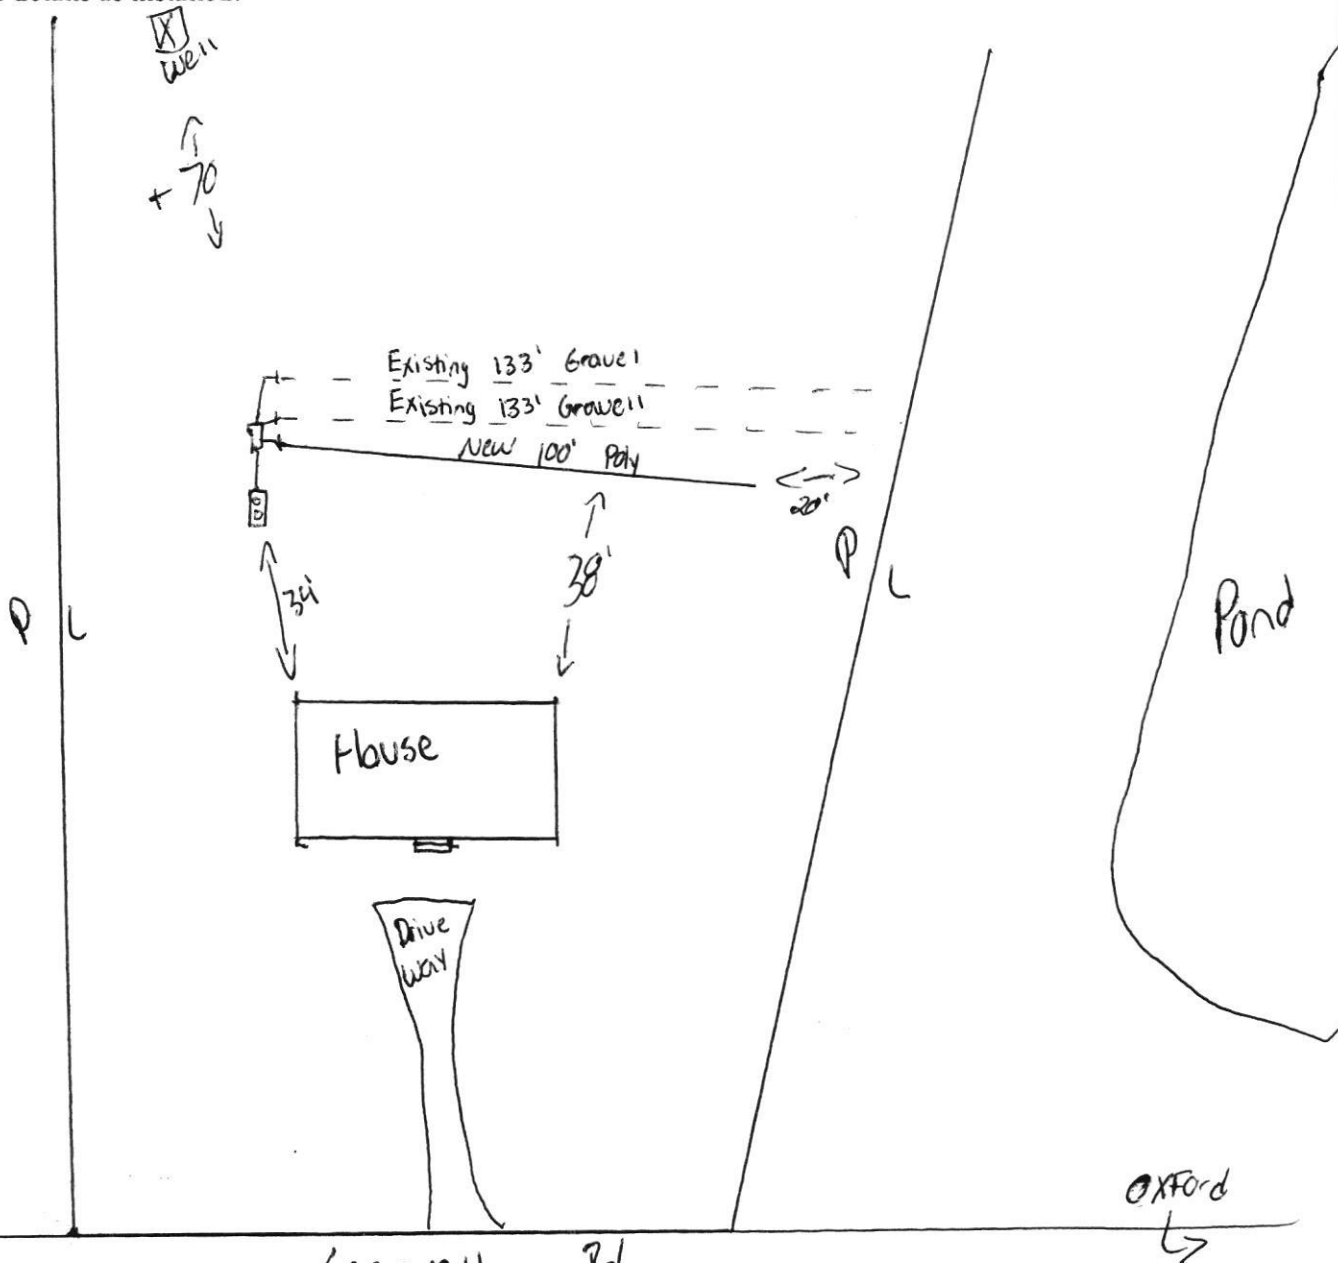

Alan L. Ellis
Authorized Signature

4/11/25
Date

SEWAGE DISPOSAL SYSTEM INSTALLATION REVIEW

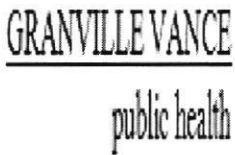

OPERATION PERMIT

Granville County Health Dept
Environmental Health
101 Hunt Drive
Oxford, NC 27565
Phone: (252) 492-5263 Fax: (252) 492-2361

For Office Use Only

*CDP File Number 405661 - 1
County ID Number: 190604533642
Evaluated For: EXISTING

Property Owner: Clay Breedlove
Owner Address: 7082 Cornwall Rd

City: Oxford
State/Zip: NC/ 27565
Phone #: (919) 603-4775 (919) 603-4775
Address: 7082 Cornwall Rd
Oxford, NC 27565

Road #:
Township:
Subdivision:
Phase : NEW Lot:

Structure: SINGLE FAMILY
of Bedrooms: 3
of People:
Water Supply: EXISTING WELL
Saprolite System?: ☐ Yes ☒ No
Pump Required?: ☐ Yes ☒ No
Design Flow:
System Classification/Description: TYPE III G. OTHER
NON-CONV. TRENCH SYSTEMS

Installer: Clayton Breedlove

Certification #: 5699I

Specific System POLYSTYRENE AGGREGATE
Installed:

Septic Tank Date: Existing

STB:

Pump Tank Date: _____

PT:

Comments: Installed 1 100ft line
to go from 2BR → 3BR.

This system has been installed in compliance with applicable NC General Statutes, Rules for Sewage Treatment and Disposal, and all conditions of the Improvement Permit and Construction Authorization.

PERMIT CONDITIONS:

- I. Performance: System shall perform in accordance with Rule .1301.
- II. Monitoring: As required by Rule .1301.
- III. Maintenance: Ground absorption sewage treatment and disposal systems shall be checked, and the contents of the septic tank removed, periodically from all compartments, to ensure proper operation of the system. The contents shall be pumped whenever the solids level is found to be more than 1/3 of the liquid depth in any compartment.

Other:

Subsurface Operator Required: ☐ Yes ☒ No

If yes, see attached sheet for additional operation conditions, maintenance and reporting.

Operation:

Other:

Authorized State Agent: Wilkerson, Austin

Austin Wilkerson REHS

Date of Issue: 04/11/2025

Owner/Applicant:

Clayton Breedlove