

GRANVILLE-VANCE HEALTH DEPARTMENT—Sewage Disposal Record

Owner or Contractor Master's Properties, Inc Date 3-29-06 S.R. No. 1714
 Location/Address Chatham Court off Woodland Church Rd
 Subdivision/Mobile Home Park Name Merrivether Lot Size 1.199 acres
 Permit No. # 05760 Lot No. 10

New System ☒ Repair _____
 House ☒ Mobile Home _____ Business _____
 No. Bedrooms 4 No. People _____ No. Toilets _____
 Water Supply: Private ☒ Approved _____
 Semi-Public _____ Unapproved _____
 Public _____ None _____

Nitrification System: Septic pressure manifold pump tank
 Tank Size 1000 gal. 1000 gal

Distribution Box ☒ No. Lines 4

Nitrification Field 1920 Sq. Ft.

Lines:	1	2	3	4	5	6
Width	<u>3'</u>	<u>3'</u>	<u>3'</u>	<u>3'</u>		
Length	<u>120'</u>	<u>120'</u>	<u>120'</u>	<u>120'</u>		
Grade	<u>0"</u>	<u>0"</u>	<u>0"</u>	<u>0"</u>		
Stone Depth	<u>12</u>	<u>12</u>	<u>12</u>	<u>12</u>		

EZ Flow unit,


Layout to be followed by installer:

Improvements Permit By David Cumbel Installer David Brantley & Sons

Certificate of Completion By Eddie Yount Date of Inspection 3-29-06

* Construction must comply with all other applicable state and local regulations, but the permit is not a guarantee that the system will not malfunction and the Granville-Vance Health District will not be held responsible for a malfunctioning system.

E2 Flow

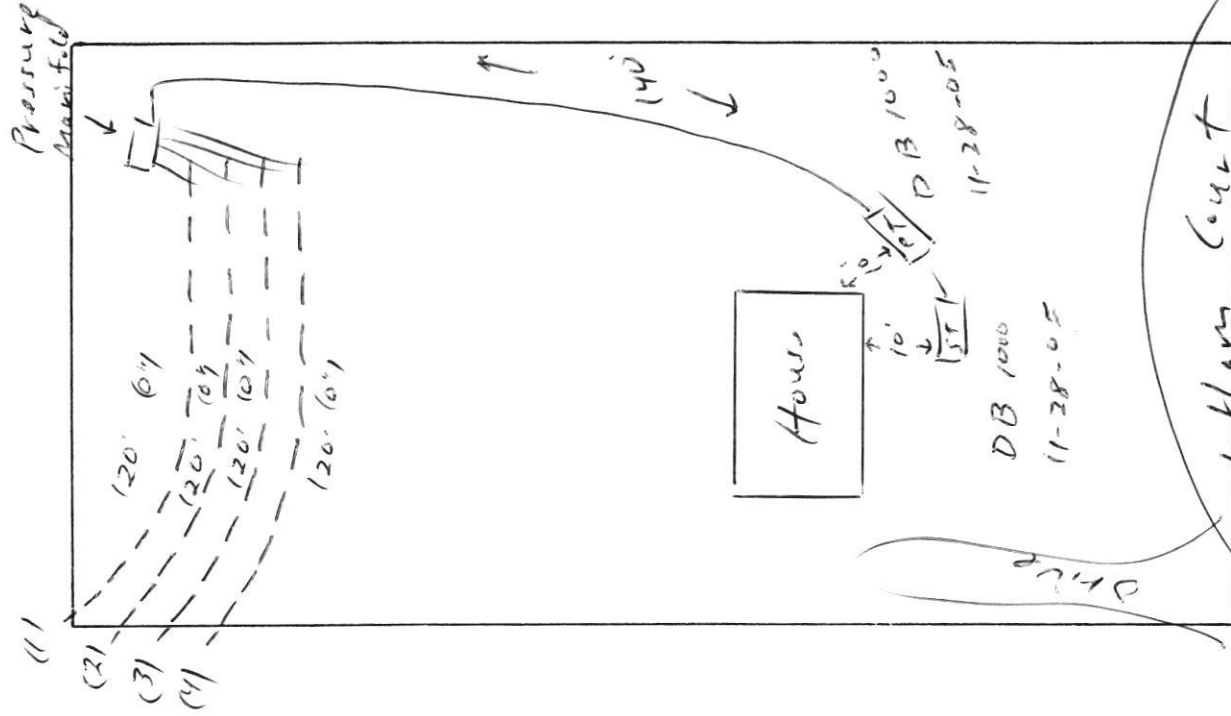

NOTE: Make sketch of installation showing location of house, septic tanks, privies, water supplies on adjacent property, etc. Write in measurements in order that installations may be located at later date.

Chatham Court

Cal. Sa - Sec

Woodland Chund Rd

J.R. 1714