

PERMIT NUMBER 10202

**GRANVILLE-VANCE DISTRICT HEALTH DEPARTMENT
IMPROVEMENT AND OPERATION PERMITS**

COUNTY:	TAX NO.	TYPE OF ESTABLISHMENTS			*THIS PERMIT SHALL BE ACCOMPANIED BY A LAYOUT SHOWN ON A PLAT, INCLUDING SYSTEM REQUIREMENTS.
	SR. NO.	RESIDENCE BUSINESS OTHER	NUMBER OF BEDROOMS:	NUMBER OF OCCUPANTS:	
OWNER:		WATER SUPPLY	WELL PUBLIC	OTHER	
APPLICANT'S ADDRESS:		TYPE OF WASTEWATER SYSTEM	INITIAL INSTALLATION	REPAIR	
PROPERTY ADDRESS/LOCATION:		DESIGN FLOW:			
SUBDIVISION:		LITAR:			
LOT NUMBER:		ABSORPTION AREA:			
REFERENCE SKETCH (SEE PLAT FOR DETAILS)		TRENCH WIDTH:			
		TRENCH DEPTH:			
		TRENCH SPACING:			
		TOTAL TRENCH LENGTH:			
		NUMBER OF TRENCHES:			
		GRAVEL DEPTH:			
		TANK SIZE:			
	PUMP/TANK SIZE:				
	DISTRIBUTION DEVICE:				
					*THIS IMPROVEMENT PERMIT IS SUBJECT TO REVOCATION IF THE INTENDED USES CHANGE FROM THOSE SHOWN ON THE IMPROVEMENT PERMIT. CHANGES SHALL REQUIRE HEALTH DEPARTMENT APPROVAL.
					PERMIT VALID FOR: 5 YEARS YES NO
					NO EXPIRATION YES NO

IMPROVEMENT PERMIT

DATE:

See new

FOR:

ISSUED BY:

Bike Sketch

5-10-10

CONSTRUCTION AUTHORIZATION FOR IMPROVEMENT PERMIT#

Unless otherwise indicated, the same conditions above apply regarding system type, layout, location and installation requirements.
(The wastewater system cannot be installed until authorization is signed)

Comments:

Date: 4-17-07

Environmental Health Specialists:

Construction Authorization Addendum

☐ Yes ☒ No

OPERATION PERMIT

DATE:

SYSTEM INSTALLED BY:

ISSUED BY:

PERFORMANCE, MONITORING, MAINTENANCE AND OPERATION
AS REQUIRED BY RULE .1961

Granville - Vance District Health Department

00329

Environmental Health

Well Construction Permit

Owner/Applicant: Wayland ButlerDate: 6-14-10Address or Location of Property: Old Farm Rd → (L) into Stormwater Forest → (L) into Section (1) → lot in (B) is cul-de-sacSubdivision & Lot #: Stormwater Forest - lot #21 Septic Permit #: 6232Zoning Permit #: 15050Environmental Health Specialist: Champion

This well permit is to locate and site the area that a private groundwater well may be established on the property listed above by the Environmental Health Specialists of Granville County. If one does not locate the well in the approved area and complete the well as specified by the 15A NCAC .02C rules, then permits may be revoked. At completion of drilling of the well, grout must be witnessed by EHS and a well log turned into Environmental Health.

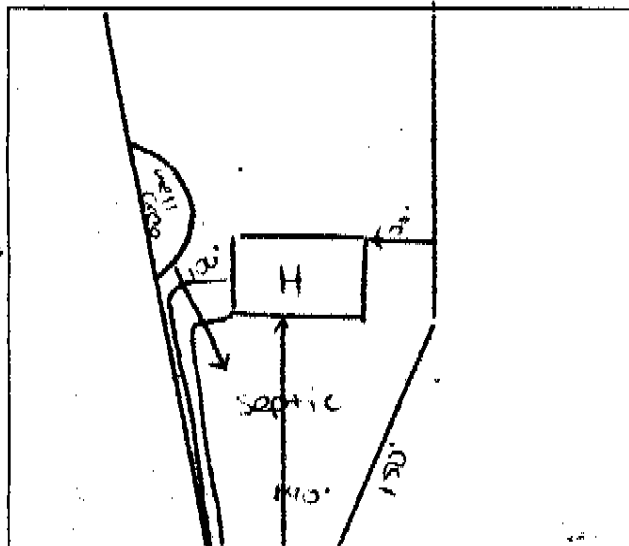
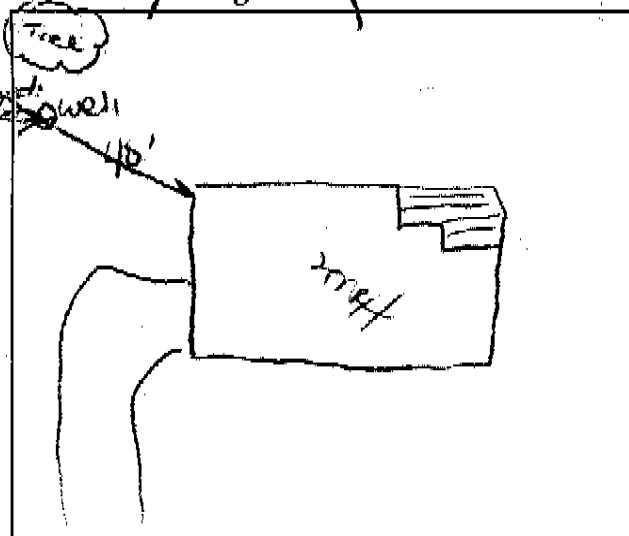
Minimum Setbacks: (these are the main setbacks, but not all required setbacks)

Setback from property lines – 10 ft

Setback from septic tank and drain field, including repair area – 100 ft

Setback from structural foundations – 25 ft

Setback from ponds, lakes or other bodies of water – 50 ft

Site Sketch:**As Built Drawing:****Conditions:**

Authorized Agent: Carol ChampionDate: 6-14-10**# 1 Well Grout: (Circle or write in)**Witnessed: Yes or No EHS Agent: ChampionDate: 9-23-10 Annular Space Open: Yes or NoOver reamed: Yes or No Depth Grouted: 20'Method: ✓ Pump Poured Pressure

Well Log received: Yes or No. (EHS to Attach to Permit)

Driller Name: Darch Cert. # 3900Depth: 500 Casing Depth: 151' GPM: 5**# 2 Well Final: (Place a check mark when finalized)**Seal Present and Intact: ✓ Air Vent: ✓Hose Spigot: ✓ Electrical Box: ✓Pump Installer Tag: ✓ Well Installer Tag: ✓All holes sealed: ✓ 12" above grade: ✓**Comments:**

300 Tgpm

3 Well Completion Permit: Carol Champion EHSDate Completed: 12-21-10**# 4 Water Samples Taken: Date:**EHS: Results: Retest: Results:

Granville - Vance District Health Department
Environmental Health

Pin 183600165291

Permit Number 6282

☒ Improvement Permit

☒ Construction Authorization

Final Sketch

Woodland Bunko
Applicants Name

Starnant Forest - 1st 21
Subdivision - Section - Lot

Physical Address: Sapphire Ct

Blackley
System Installer

12-10-10
Date

System design and details as installed.

Septic Tank Information:

Date: 2-10-10

Manufacture: Ellis-1000

ID #: 578-789

Pump Tank Information:

Date: /

Manufacturer: /

ID #: /

Distribution Box ☒

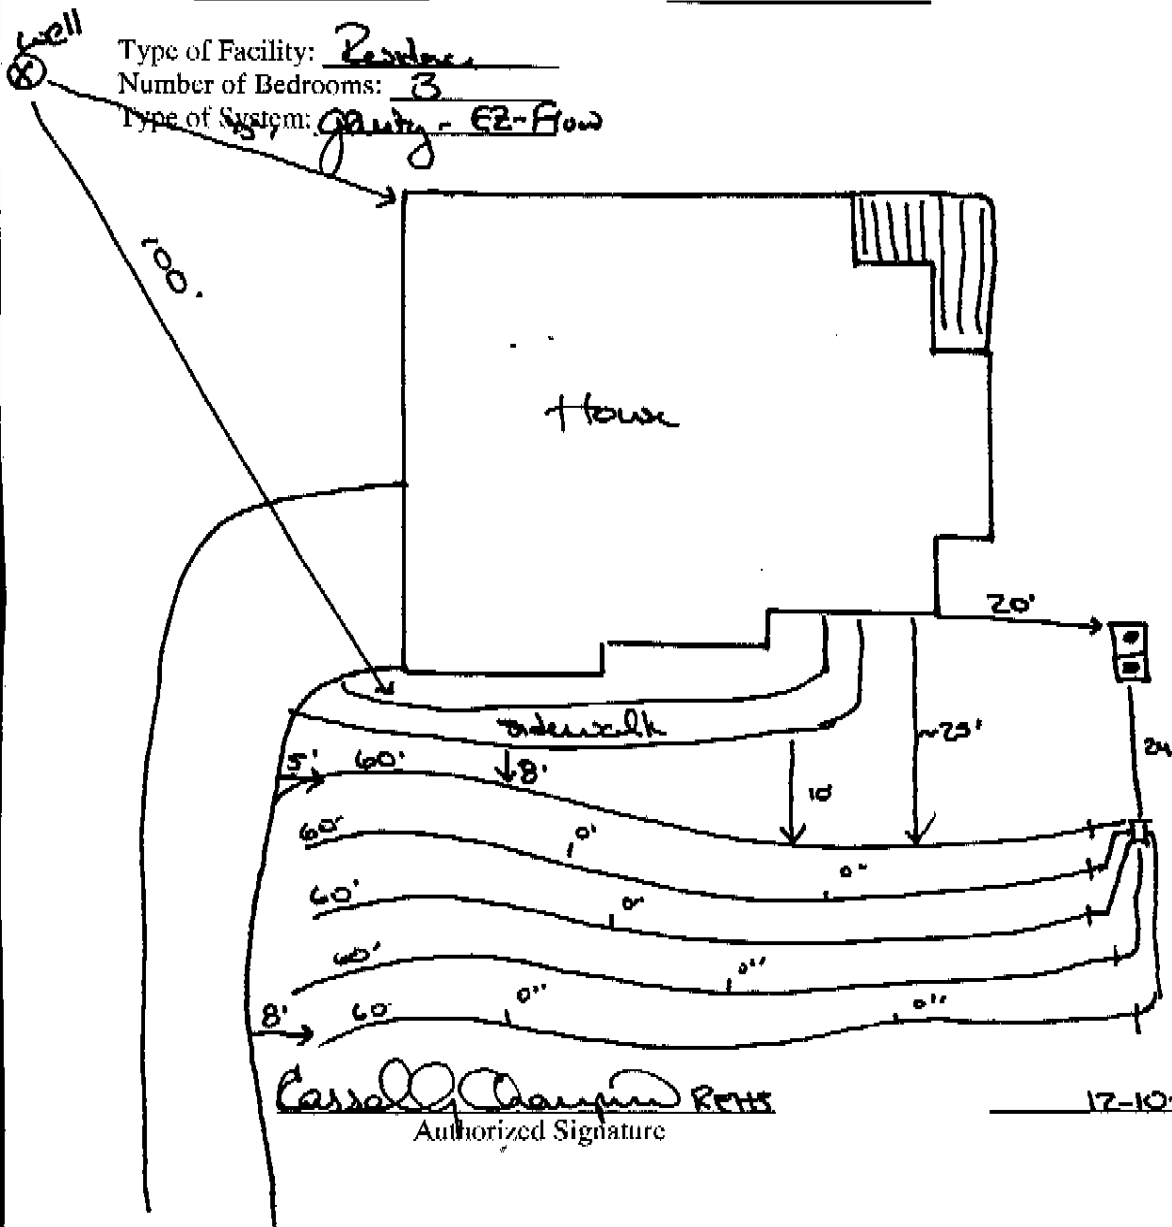
Pressure Manifold

Serial Distribution

Type of Facility: Residence

Number of Bedrooms: 3

Type of System: Gravity - EZ-Flow



Cassidy Champion RHTS
Authorized Signature

12-10-10
Date