

Environmental Health Well Construction Permit


Owner/Applicant: Woodland Builder Date: 6-14-10
 Address or Location of Property: Old Franklinton Rd → (L) into Starmans Forest → (L) into Sapphire Ct → lot on (R) in cul-de-sac
 Subdivision & Lot #: Starmans Forest - lot #21 Septic Permit #: 6282
 Zoning Permit #: 15050 Environmental Health Specialist: Champion

This well permit is to locate and site the area that a private groundwater well may be established on the property listed above by the Environmental Health Specialists of Granville County. If one does not locate the well in the approved area and complete the well as specified by the 15A NCAC .02C rules, then permits may be revoked. At completion of drilling of the well, grout must be witnessed by EHS and a well log turned into Environmental Health.

Minimum Setbacks: (these are the main setbacks, but not all required setbacks)

Setback from property lines – 10 ft Setback from septic tank and drain field, including repair area – 100 ft
 Setback from structural foundations – 25 ft Setback from ponds, lakes or other bodies of water – 50 ft

Site Sketch:

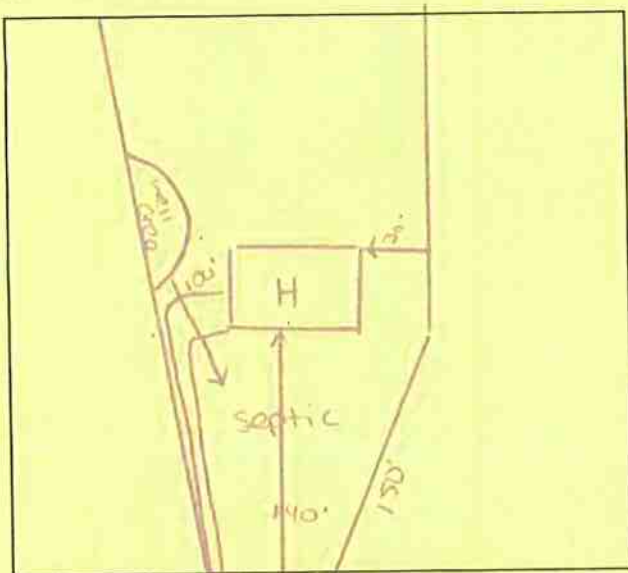

Conditions:

Authorized Agent: Carroll Champion EHS

Date: 6-14-10

1 Well Grout: (Circle or write in)

Witnessed: Yes or No EHS Agent: Champion
 Date: 9-23-10 Annular Space Open: Yes or No
 Over reamed: Yes or No Depth Grouted: 22'
 Method: ✓ Pump Poured Pressure
 Well Log received: Yes or No (EHS to Attach to Permit)
 Driller Name: Daren Cert. # 3900
 Depth: 560 Casing Depth: 151' GPM: 5

2 Well Final: (Place a check mark when finalized)

Seal Present and Intact: ✓ Air Vent: ✓
 Hose Spigot: ✓ Electrical Box: ✓
 Pump Installer Tag: ✓ Well Installer Tag: ✓
 All holes sealed: ✓ 12" above grade: ✓

Comments:

300 1gpm

3 Well Completion Permit: Carroll Champion EHS

Date Completed: 12-21-10

4 Water Samples Taken: Date: _____

EHS: _____ Results: _____

Retest: _____ Results: _____

As Built Drawing:

