


NOTE: Make sketch of installation showing location of house, septic tanks, privies, water supplies on adjacent property, etc. Write in measurements in order that installations may be located at later date.

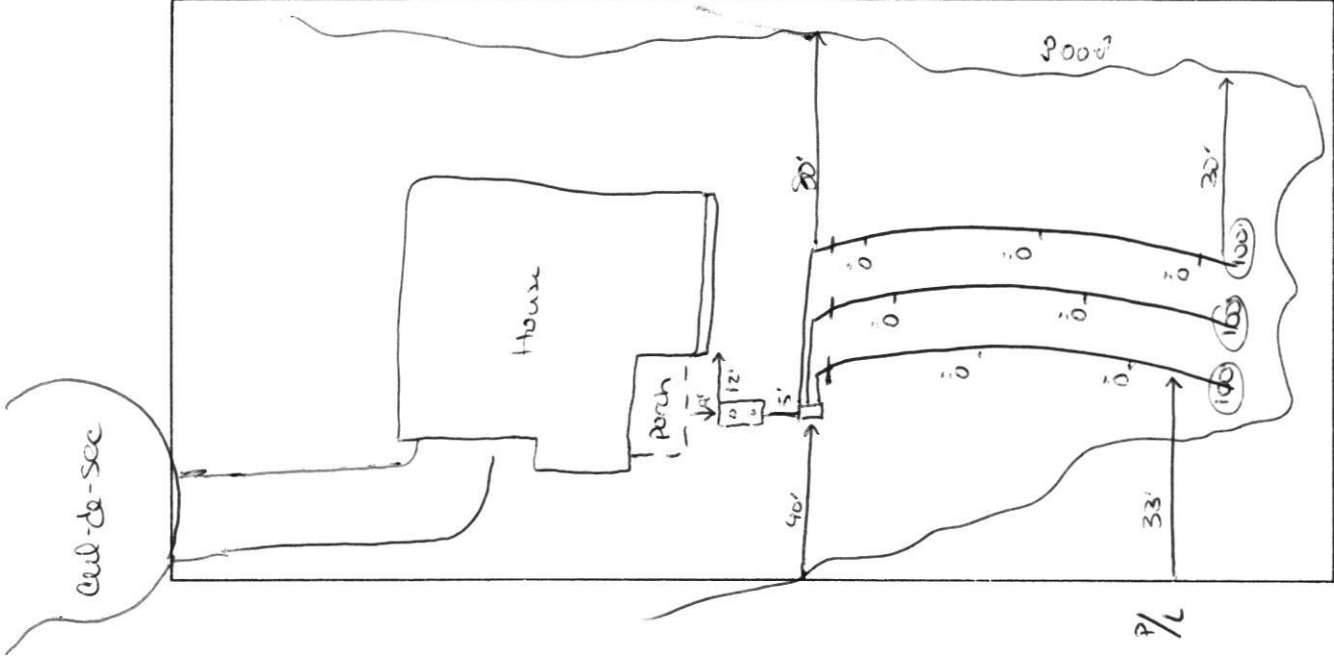

GRANVILLE-VANCE HEALTH DEPARTMENT—Sewage Disposal Record

Owner or Contractor Wynn Construction Date 1-15-08 S.R. No. 1639
Location/Address Philo White → Flat Rock Rd → Brookdale subd. → end of cul-de-sac on (R)
Subdivision/Mobile Home Park Name Brookdale Lot Size 1.863
Permit No. # 6226 Lot No. 20

New System ☒ Repair _____
House ☒ Mobile Home _____ Business _____
No. Bedrooms 3 No. People max 6 No. Toilets _____
Water Supply: Private ☒ Approved _____
Semi-Public _____ Unapproved _____
Public _____ None _____

Nitrification System:

Tank Size 1000 gal.
Distribution Box ☒ No. Lines 3
Nitrification Field 1200 Sq. Ft.

Lines:	1	2	3	4	5	6
Width	<u>36"</u>	<u>36"</u>	<u>36"</u>	_____	_____	_____
Length	<u>100'</u>	<u>100'</u>	<u>100'</u>	_____	_____	_____
Grade	<u>0"</u>	<u>0"</u>	<u>0"</u>	_____	_____	_____

Stone Depth EZ-Flow _____

Layout to be followed by installer:

- were not drilled at time of inspection.

- Tank Info

Ellis - 1000

STB - 789

9-10-07

Improvements Permit By M.E. Yant, RS. Installer Blackley
Certificate of Completion By Cassandra Champion, RS Date of Inspection 1-14-08

* Construction must comply with all other applicable state and local regulations, but the permit is not a guarantee that the system will not malfunction and the Granville-Vance Health District will not be held responsible for a malfunctioning system.