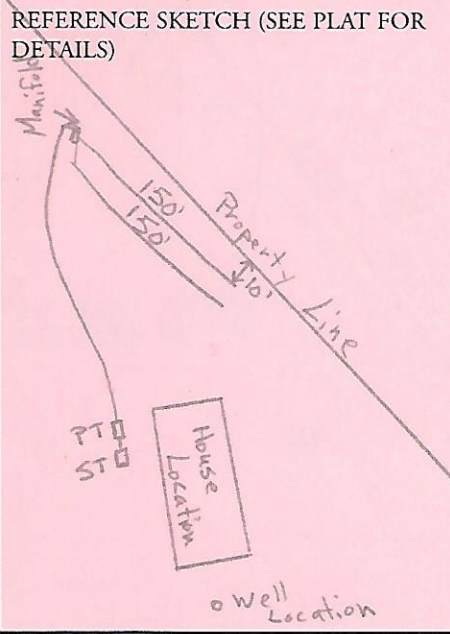


Pump
System

PERMIT NUMBER 4309

GRANVILLE-VANCE DISTRICT HEALTH DEPARTMENT IMPROVEMENT AND OPERATION PERMITS

COUNTY:	TAX NO. <u>0470 03028</u>	TYPE OF ESTABLISHMENT			*THIS PERMIT SHALL BE ACCOMPANIED BY A LAYOUT SHOWN ON A PLAT, INCLUDING SYSTEM REQUIREMENTS. *THE IMPROVEMENTS PERMIT MUST BE ATTACHED TO A CONSTRUCTION AUTHORIZATION BEFORE OBTAINING BUILDING PERMIT OR OTHER CONSTRUCTION PERMITS AND BEFORE A WASTEWATER SYSTEM IS INSTALLED. *THIS IMPROVEMENT PERMIT IS SUBJECT TO REVOCATION IF THE INTENDED USES CHANGE FROM THOSE SHOWN ON THE IMPROVEMENT PERMIT. CHANGES SHALL REQUIRE HEALTH DEPARTMENT APPROVAL.
<u>Vance</u>	SR. NO.	RESIDENCE ☒	NUMBER OF BEDROOMS:	NUMBER OF OCCUPANTS:	
OWNER: <u>Sara Cruz</u>		BUSINESS ☐	<u>3</u>	<u>1</u>	
APPLICANT: <u>Math (Elletwood Homes)</u>		OTHER ☐			
APPLICANT'S ADDRESS:		WATER SUPPLY			
		PUBLIC ☐	WELL ☒	OTHER ☐	
PROPERTY ADDRESS/LOCATION: <u>Kithell Rd.</u> <u>Approx. 1 mile East of Kithell on right</u>		TYPE OF WASTEWATER SYSTEM			
		<u>Pump to Conv. (Type III)</u>			
SUBDIVISION: <u>824 Kithell Rd</u> LOT NUMBER:		DESCRIPTION	INITIAL INSTALLATION	REPAIR	
				<u>Same</u>	
		DESIGN FLOW:	<u>360 g/day</u>		
		LTAR:	<u>.4</u>		
REFERENCE SKETCH (SEE PLAT FOR DETAILS) 		ABSORPTION AREA:	<u>900 sq ft</u>		
		TRENCH WIDTH:	<u>3'</u>		
		TRENCH SPACING:	<u>9'</u>		
		TOTAL TRENCH LENGTH:	<u>300'</u>		
		NUMBER OF TRENCHES:	<u>3</u>		
		GRAVEL DEPTH:	<u>12"</u>		
		TANK SIZE:	<u>1,000 g ST</u> <u>1,000 g PT</u>		
		CONDITIONS:	<u>30" Trench Depth</u>	<u>NEMA 4X Control Panel</u>	
IMPROVEMENT PERMIT				DATE:	
FOR: <u>Sara Cruz</u>					
ISSUED BY: <u>Mac Shingleton, P.E.</u>				<u>12-14-04</u>	
OPERATION PERMIT				DATE:	
SYSTEM INSTALLED BY: <u>Cole Backhoe Service</u>					
ISSUED BY: <u>Mac Shingleton, P.E.</u>				<u>1-13-05</u>	

PERMIT VALID FOR
5 YEARS FROM
DATE OF ISSUE