
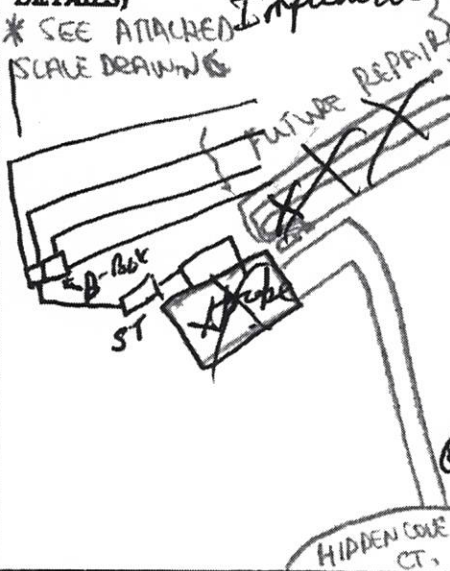


10-10-30
 Mike Dunn
 Triangle Pump and Tank
 PERMIT NUMBER 2434

**GRANVILLE - VANCE DISTRICT HEALTH DEPARTMENT
 IMPROVEMENT AND OPERATION PERMITS**

COUNTY: GRANVILLE	TAX NO.	TYPE OF ESTABLISHMENT			*THIS PERMIT SHALL BE ACCOMPANIED BY A LAYOUT SHOWN ON A PLAT, INCLUDING SYSTEM REQUIREMENTS. *THE IMPROVEMENTS PERMIT MUST BE ATTACHED TO A CONSTRUCTION AUTHORIZATION BEFORE OBTAINING BUILDING PERMIT OR OTHER CONSTRUCTION PERMITS AND BEFORE A WASTEWATER SYSTEM IS INSTALLED. *THIS IMPROVEMENT PERMIT IS SUBJECT TO REVOCATION IF THE INTENDED USE CHANGE FROM THOSE SHOWN ON THE IMPROVEMENT PERMIT. CHANGES SHALL REQUIRE HEALTH DEPARTMENT APPROVAL.
	SR NO. 1139	RESIDENCE ☒ BUSINESS ☐ OTHER ☐	NUMBER OF BEDROOMS: 3	NUMBER OF OCCUPANTS: ≤ 6	
OWNER: JOHN McDANIELS					
APPLICANT: ADVANCE Homes		WATER SUPPLY			
APPLICANT'S ADDRESS: YOUNGSVILLE 188 NORTH BEND DR.		PUBLIC ☐	WELL ☒	OTHER ☐	
PROPERTY ADDRESS/LOCATION: SID MITCHELL RD.		TYPE OF WASTEWATER SYSTEM			
		DESCRIPTION	INITIAL INSTALLATION	REPAIR	
SUBDIVISION: WOODCROFT II		DESIGN FLOW:	360 gal/day		
LOT NUMBER: 53		LTAR:	0.35		
REFERENCE SKETCH (SEE PLAT FOR DETAILS) * SEE ATTACHED <i>Infiltration</i> SCALE DRAWING 		ABSORPTION AREA:	1029 72'		
		TRENCH WIDTH:	3'		
		TRENCH SPACING:	9' ON CENTERS		
		TOTAL TRENCH LENGTH:	343' 257'		
		NUMBER OF TRENCHES:	4-5		
		GRAVEL DEPTH:	12"		
		TANK SIZE:	900 GAL		
		CONDITIONS:			
IMPROVEMENT PERMIT FOR: ADVANCE Homes ISSUED BY: <i>Paul I. M.</i>					DATE: 4-21-00
OPERATION PERMIT SYSTEM INSTALLED BY: Triangle Pump and Tank ISSUED BY: <i>Jimmy B. Clayton, RS</i>					DATE: 9-14-00

NOTE: Make sketch of installation showing location of house, septic tanks, privies, water supplies on adjacent property, etc. Write in measurements in order that installations may be located at later date.

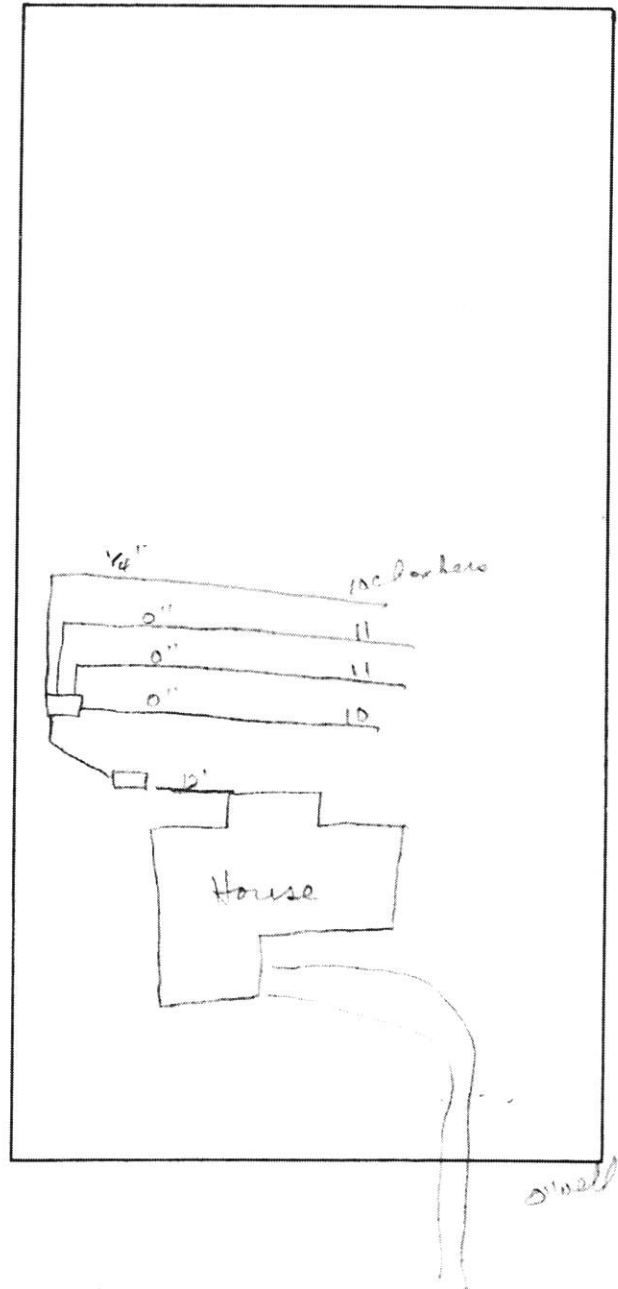

GRANVILLE-VANCE HEALTH DEPARTMENT Sewage Disposal Record

Owner or Contractor John McDaniel / Adams Home Date 9-14-00 R. No. 1139
 Location/Address Hidden Cove Ct. 1st end of Rd
 Subdivision/Mobile Home Park Name Woodcroft Lot Size 2.303
 Permit No. # 2434 Lot No. 53

Layout to be followed by installer:

New System ☒ Repair _____
 House ☒ Mobile Home _____ Business _____
 No. Bedrooms 3 No. People 6 No. Toilets _____
 Water Supply: Private ☒ Approved _____
 Semi-Public _____ Unapproved _____
 Public _____ None _____

Nitrification System:

Tank Size 900 gal.
 Distribution Box 15 No. Lines 4
 Nitrification Field 257 Sq. Ft.
 Lines: 3 2 3 4 5 6
 Width 3 3 3 3
 Length 10 11 10 chambers
 Grade 1/2" 0 0 0
 Stone Depth - - - -

Infiltration chamber system

Improvements Permit By PAO 1 Gower Installer Travis P. P. T. T. T.
 Certificate of Completion By Simon C. C. C. Date of Inspection 9-14-00

* Construction must comply with all other applicable state and local regulations, but the permit is not a guarantee that the system will not malfunction and the Granville-Vance Health District will not be held responsible for a malfunctioning system.