

10:45
or 23

Pump

PERMIT NUMBER 07542

GRANVILLE-VANCE DISTRICT HEALTH DEPARTMENT
IMPROVEMENT AND OPERATION PERMITS

Zone A
17192

COUNTY:	TAX NO.	TYPE OF ESTABLISHMENTS			*THIS PERMIT SHALL BE ACCOMPANIED BY A LAYOUT SHOWN ON A PLAT, INCLUDING SYSTEM REQUIREMENTS.
Granville	183600203210	RESIDENCE ☒	NUMBER OF BEDROOMS:	NUMBER OF OCCUPANTS:	
	SR. NO.	BUSINESS ☐	4	8 max	
	OWNER: Steven Hayes	OTHER ☐	WATER SUPPLY	WELL ☒	
APPLICANT'S ADDRESS:		TYPE OF WASTEWATER SYSTEM	INITIAL INSTALLATION	REPAIR	*THIS IMPROVEMENT PERMIT IS SUBJECT TO REVOCATION IF THE INTENDED USES CHANGE FROM THOSE SHOWN ON THE IMPROVEMENT PERMIT. CHANGES SHALL REQUIRE HEALTH DEPARTMENT APPROVAL.
28 Hayes Ct. Franklin		DESIGN FLOW:	Type III b.g. 480 gpd	Type III b.g.	
PROPERTY ADDRESS/LOCATION:		LTAR:			
1631 Carriage Ct		ABSORPTION AREA:	3 gpd/ft ²		
SUBDIVISION: Montgomery A.		TRENCH WIDTH:	3'		
LOT NUMBER: 24		TRENCH DEPTH:	24"		
REFERENCE SKETCH (SEE PLAT FOR DETAILS)		TRENCH SPACING:	9' o.c.		
• Try to keep tanks + 15' from neighbors well • Option 1 would be best to keep 10' well set back • stay 125' from upper side house foundation		TOTAL TRENCH LENGTH:	400'		
		NUMBER OF TRENCHES:	4		
		GRAVEL DEPTH:	Accepted 5' status		
		TANK SIZE:	1200 gal		
		PUMP TANK SIZE:	1200 gal		
		DISTRIBUTION DEVICE:	Pressure manifold		PERMIT VALID FOR: 5 YEARS YES ☒ NO ☐
					NO EXPIRATION YES ☐ NO ☒

***** IMPROVEMENT PERMIT DATE: 5/9/13 *****

FOR: Steven Hayes
ISSUED BY: David Cumber

CONSTRUCTION AUTHORIZATION FOR IMPROVEMENT PERMIT# 7542

Unless otherwise indicated, the same conditions above apply regarding system type, layout, location and installation requirements.
(The wastewater system cannot be installed until authorization is signed)

Comments: install in dry conditions - call 693-2685 w/quote

Date: 5-9-13 Environmental Health Specialist: David Cumber
Construction Authorization Addendum ☐ Yes ☒ No

***** OPERATION PERMIT DATE: 2-12-15 *****

SYSTEM INSTALLED BY: David Brantley & Sons
ISSUED BY: David Cumber

PERFORMANCE, MONITORING, MAINTENANCE AND OPERATION
AS REQUIRED BY RULE .1961

Granville - Vance District Health Department
Environmental Health

Pin 183600203210

Permit Number 7542

☒ Improvement Permit

☒ Construction Authorization

Final Sketch

Steven Hayes
Applicants Name

Montgomery Place 24
Subdivision - Section - Lot

Physical Address: 1631 Carriage Ct.

David Brantley & Sons
System Installer

2-12-15
Date

System design and details as installed.

Septic Tank Information:

Date: 11-14-14

Manufacture: DB-1250

ID #: 5TB-398

Pump Tank Information:

Date: 11-4-14

Manufacture: DB-1200

ID #: PT-463

Distribution Box

Pressure Manifold ☒

Serial Distribution


Pump Info: Zoeller N152-B

Type of Facility: House Number of Bedrooms: 4 Well Drilled at time of inspection: Y or N

Type of System: Gravity ☒ Pump Gravel ☒ Polystyrene Chamber Other: _____

Well Info: Date drilled: _____ Driller Name: _____ Depth: _____ GPM: _____ Casing: _____

Pump Depth _____ Pump HP: _____ Installer Name: _____

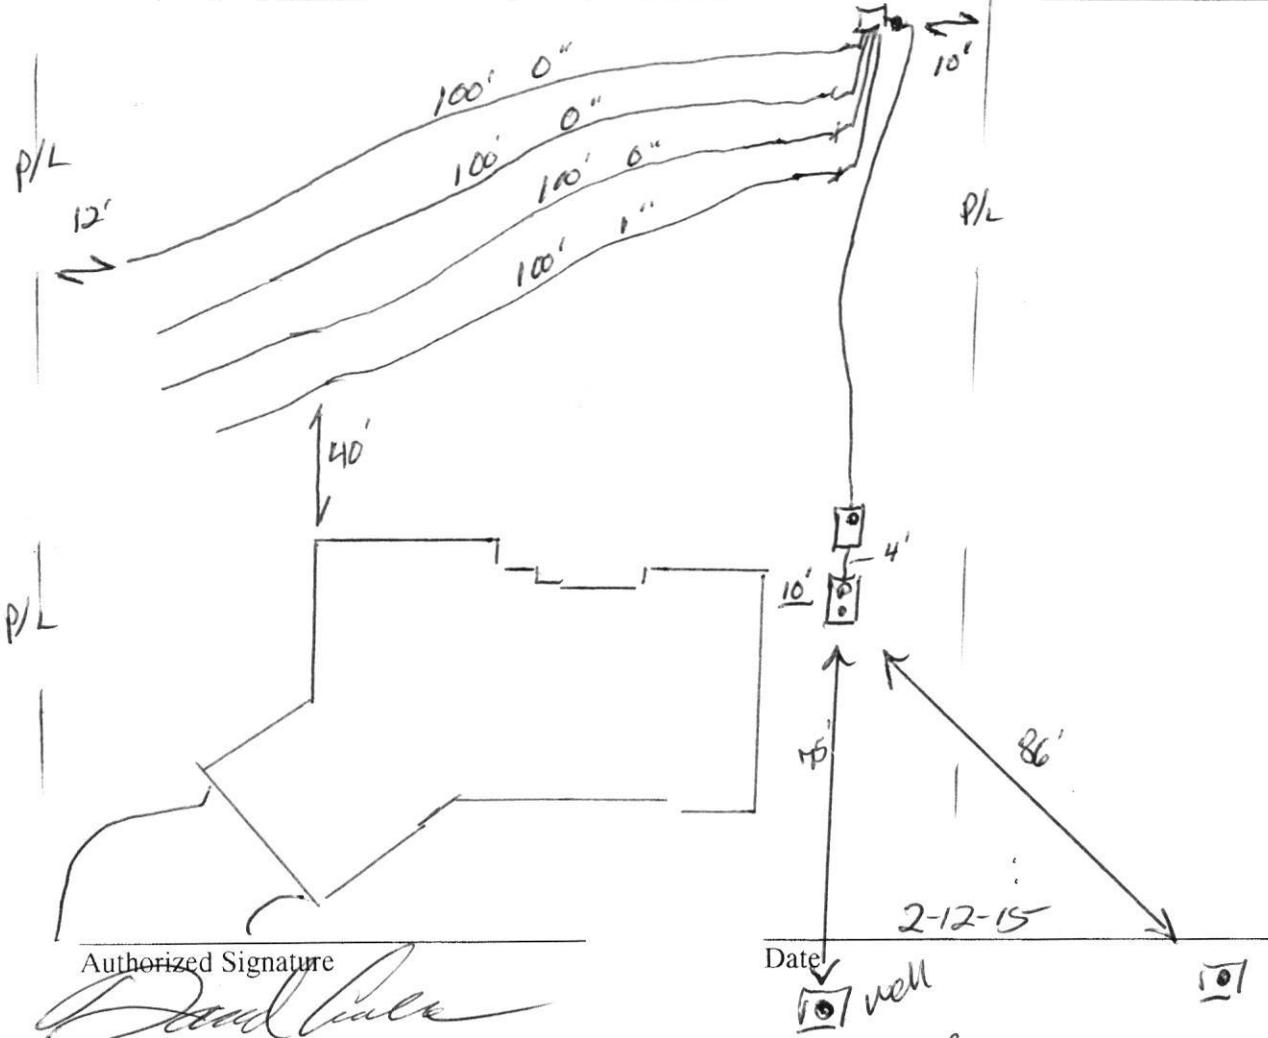

Granville - Vance District Health Department

Environmental Health

Well Construction Permit

Owner/Applicant: Sharon Hayes Date: 5/9/13
Address or Location of Property: 1631 Carriage Ct.


Subdivision & Lot #: Montgomery Place Septic Permit #: 7542
Zoning Permit #: 17192 Environmental Health Specialist: Don K.

This well permit is to locate and site the area that a private groundwater well may be established on the property listed above by the Environmental Health Specialists of Granville County. If one does not locate the well in the approved area and complete the well as specified by the 15A NCAC .02C rules, then permits may be revoked. At completion of drilling of the well, grout must be witnessed by EHS and a well log turned into Environmental Health.

Minimum Setbacks: (these are the main setbacks, but not all required setbacks)

Setback from property lines - 10 ft Setback from septic tank and drain field, including repair area - 100 ft
Setback from structural foundations - 25 ft Setback from ponds, lakes or other bodies of water - 50 ft

Site Sketch:

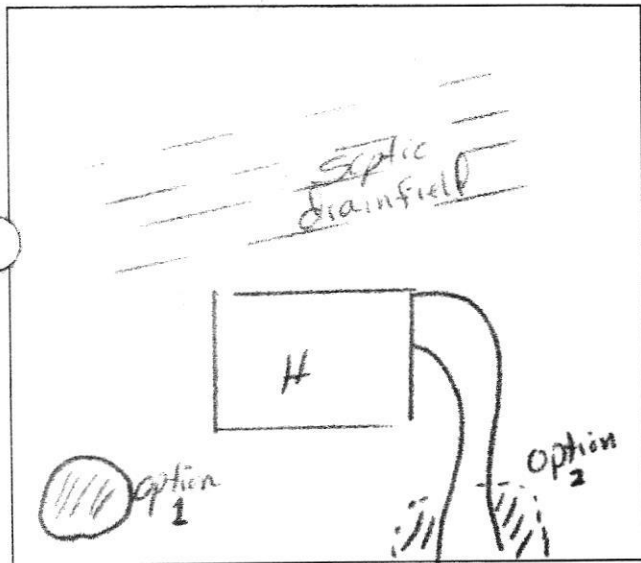

Conditions: Please call 6932658
prior to drilling -
(Not sure of option chosen at this time)

Authorized Agent: Don K.
Date: 5/9/13

1 Well Grout: (Circle or write in)


Witnessed: Yes or No EHS Agent: Chapman
Date: 9-23-14 Annular Space Open: Yes or No
Over reamed: Yes or No Depth Grouted: 20+
Method: Pump Poured Pressure
Well Log received: Yes or No (EHS to Attach to Permit)
Driller Name: Stephenson Cert. #
Depth: 185' Casing Depth: 73 GPM: 12

2 Well Final: (Place a check mark when finalized)

Seal Present and Intact: ✓ Air Vent: ✓
Hose Spigot: ✓ Electrical Box: ✓
Pump Installer Tag: ✓ Well Installer Tag: ✓
All holes sealed: ✓ 12" above grade: ✓

Comments:

As Built Drawing:

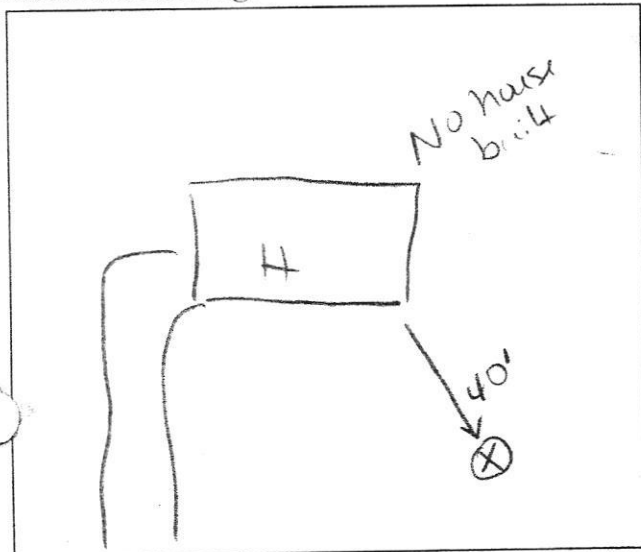

3 Well Completion Permit: Don K. EHS
Date Completed: 4-14-15

4 Water Samples Taken: Date: 4-14-15
EHS: Don K. Results:
Retest: Results:



Granville-Vance District Health Department

Lisa M. Harrison, MPH, Health Director
Post Office Box 367
Oxford, North Carolina 27565



Granville County Health Dept.
101 Hunt Drive
Oxford, NC 27565
Phone: (919) 693-2688
Fax: 919-690-0106

Vance County Health Dept.
115 Charles Rollins Road
Henderson, NC 27536
Phone: (252) 492-7915
Fax: (252) 492-4219

Recertification of an Existing On-Site System and Well

Owner Name / Applicant Name: Kevin Navy Date: 10-6-16
Physical Address: 1633 Carriage Dr. Contact Number: _____
Subdivision: Montgomery Place Lot # 24 Zoning Permit # 19573

Septic Permit #: 7542 Date Installed: 2-15

Recertification Of: _____ Bedrooms Allowed

Existing House Replacement: Size: _____

Pool: _____ - Size: _____
Septic Redesign/Upgrade: _____
Permit # _____

Addition to House: _____ - Size: _____
Bedroom Addition _____ Septic Upgrade: _____
Permit # _____ New Well: _____

Outbuilding Addition: _____ - Size: _____

Other Additions to Property: 7x7 Hot Tub

☒ Setbacks have been met accordingly at this time.

☒ Onsite Wastewater System is functioning properly at this time.

_____ Onsite Wastewater System is functioning properly at this time, but system upgrade is required.

Permit #: _____

*** System Upgrade must be completed prior to Certification of Occupancy.

_____ Onsite Wastewater System is **NOT** functioning properly at this time.

Repair Permit #: _____

*** System repair must be completed prior to Certification of Occupancy.

_____ Recertification denied, due to: _____

_____ Cannot determine due to: _____

Special Instructions: _____

[Signature]
Signature of REHS

10-6-16
Date