

GRANVILLE-VANCE HEALTH DEPARTMENT—Sewage Disposal Record


Owner or Contractor Homeplaces Date 1-8-08 S.R. No. 1631
 Location/Address 965 → Philo White → Conyers → Summer Springs → (C) on Winding Cr → lot (C)
 Subdivision/Mobile Home Park Name Summer Springs Lot Size .918 ac
 Permit No. # 6529 Lot No. 118

New System ☒ Repair ☐
 House ☒ Mobile Home ☐ Business ☐
 No. Bedrooms 3 No. People 6 No. Toilets 3
 Water Supply: Private ☒ Approved ☒
 Semi Public ☐ Unapproved ☐
 Public ☐ None ☐
 Nitrification System:
 Tank Size 1000 gal. concrete
 Distribution Box ☒ No. Lines 4
 Nitrification Field 130' x 130' Sq. Ft. 16900
 Lines:
 Width 30" 30" 30" 30"
 Length 85' 85' 85' 85'
 Grade 5.0 5.34 5.94 6.5
 Stone Depth Chamber H-10

Layout to be followed by installer:
Septic tank
DB-1000
STB-616
CAP-1000
11-1-07
well
3397
405 ft deep
67 ft casing
5 GPM
Pump
Tanks # 983
1 HP pump
depth - 375'
1-8-08

Improvements Permit By Cassandra Champion, RS Installer Karim Beckhoe
 Certificate of Completion By Cassandra Champion, RS Date of Inspection 1-8-08

* Construction must comply with all other applicable state and local regulations, but the permit is not a guarantee that the system will not malfunction and the Granville-Vance Health District will not be held responsible for a malfunctioning system.

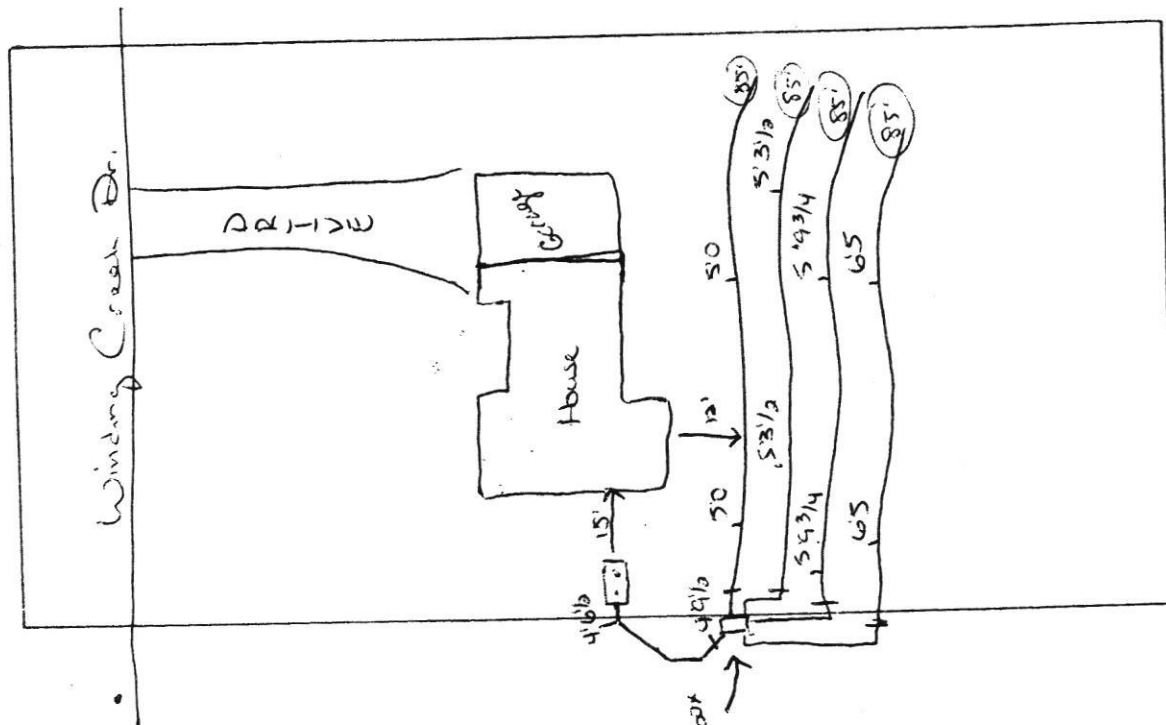

NOTE: Make sketch of installation showing location of house, septic tanks, privies, water supplies on adjacent property, etc. Write in measurements in order that installations may be located at later date.

Ramm Backhoe 4:30-2:00

450

PERMIT NUMBER 06529

GRANVILLE-VANCE DISTRICT HEALTH DEPARTMENT
IMPROVEMENT AND OPERATION PERMITS

COUNTY:	TAX NO. 183700038371	TYPE OF ESTABLISHMENTS			*THIS PERMIT SHALL BE ACCOMPANIED BY A LAYOUT SHOWN ON A PLAT, INCLUDING SYSTEM REQUIREMENTS.
OWNER: Homeplaces	SR. NO. 11631	RESIDENCE ☒ BUSINESS ☐ OTHER ☐	NUMBER OF BEDROOMS: 3	NUMBER OF OCCUPANTS: max 60	
	APPLICANT'S ADDRESS: 4098 Barrett Drive Raleigh NC 27609	WATER SUPPLY Pawake	WELL ☒ PUBLIC ☐	OTHER ☐	
PROPERTY ADDRESS/LOCATION: Conyers Rd → into Summer Springs → (6) on Winding Cr.	TYPE OF WASTEWATER SYSTEM	INITIAL INSTALLATION	REPAIR		
SUBDIVISION: Summer Springs	DESIGN FLOW:	360 gpd	360 gpd		*THIS IMPROVEMENT PERMIT IS SUBJECT TO REVOCATION IF THE INTENDED USES CHANGE FROM THOSE SHOWN ON THE IMPROVEMENT PERMIT. CHANGES SHALL REQUIRE HEALTH DEPARTMENT APPROVAL.
	LTAR:	.275	.275		
LOT NUMBER: 118	ABSORPTION AREA:	1309 Ft ²	1309 Ft ²		
	TRENCH WIDTH:	36"	36"		
REFERENCE SKETCH (SEE PLAT FOR DETAILS) - Maintain appropriate contour. - Follow setbacks - Must haul in 6" of approved soil cover to put across system.	TRENCH DEPTH:	14-16"			PERMIT VALID FOR: 5 YEARS YES ☒ NO ☐
	TRENCH SPACING:	9' on center	9' on center		
	TOTAL TRENCH LENGTH:	330 Ft			NO EXPIRATION YES ☐ NO ☒
	NUMBER OF TRENCHES:	4 lines at 83'			
	GRAVEL DEPTH:	*accepted	*accepted		
	TANK SIZE:	1000 gal			
	PUMP TANK SIZE:	-			
DISTRIBUTION DEVICE:	Distribution Box				

IMPROVEMENT PERMIT

DATE: 9-27-07

FOR: Homeplaces
ISSUED BY: Cassel Q. Chapin RS - Casey

CONSTRUCTION AUTHORIZATION FOR IMPROVEMENT PERMIT# 06529

Unless otherwise indicated, the same conditions above apply regarding system type, layout, location and installation requirements.
(The wastewater system cannot be installed until authorization is signed)

Comments: Maintain contour. Follow site slopes

Date: 9-27-07 Environmental Health Specialist: Cassel Q. Chapin RS
Construction Authorization Addendum ☐ Yes ☒ No

OPERATION PERMIT

DATE: 1-8-08

SYSTEM INSTALLED BY: Ramm Backhoe
ISSUED BY: Cassel Q. Chapin RS

PERFORMANCE, MONITORING, MAINTENANCE AND OPERATION
AS REQUIRED BY RULE .1961