


Will Smith #2



Triangle Concrete
4-24-00
AC 1000
Products -

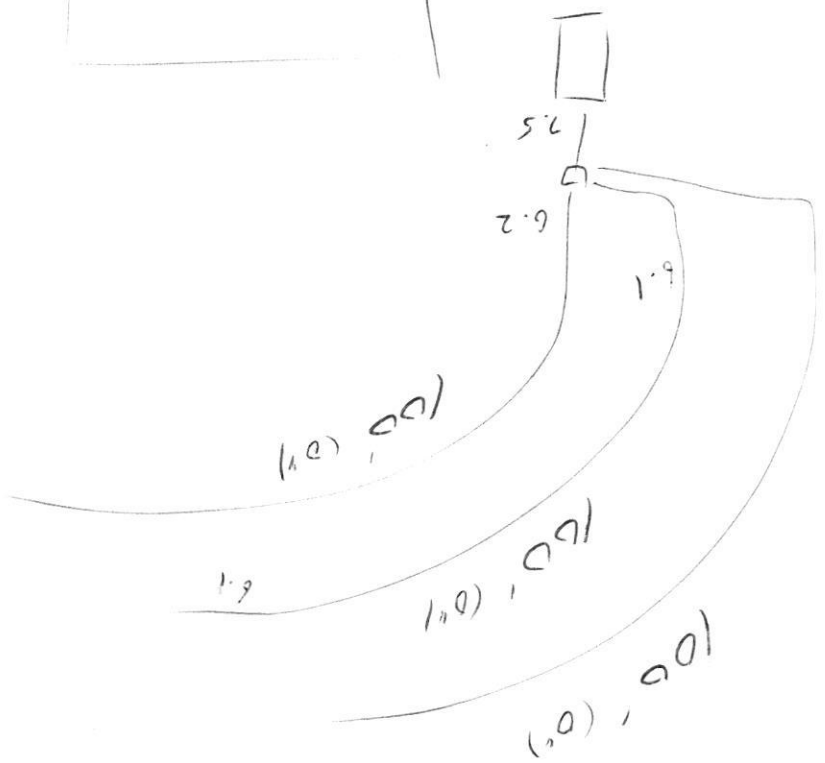

SEWAGE DISPOSAL SYSTEM INSTALLATION REVIEW

OWNER John Thompson DATE 5-4-00 CONTRACTOR Leonard O. Bryant PERMIT NUMBER 2061

WEATHER CONDITIONS Sunny SOIL WITNESS CONDITIONS Moist

SEPTIC AND PUMP TANK INSPECTION

SEPTIC TANK

MANUFACTURER Triangle Concrete Products DATE OF MANUFACTURE 4-24-00

STAMP yes

CAPACITY 1000

TEE yes

BAFFLE yes

SEALANT yes

PUMP TANK yes

MANUFACTURER yes

DATE OF MANUFACTURE yes

STAMP yes

CAPACITY yes

SEALANT yes

MANHOLE yes

DRAW DOWN TEST yes

MANUFACTURER yes

DATE OF MANUFACTURE yes

STAMP yes

CAPACITY yes

SEALANT yes

MANHOLE yes

DRAW DOWN TEST yes

MECHANICAL INSPECTION

PUMP

MANUFACTURER AND MODEL NUMBER _____

CONTROL PANEL _____

ALARM _____

ELECTRICAL CONNECTION _____

NITRIFICATION DISTRIBUTION AND DRAINFIELD INSPECTION

DISTRIBUTION BOX

LEVEL _____

EQUAL DISTRIBUTION _____

OTHER _____

DISTRIBUTION MANIFOLD

PIPE SIZE _____

GATE VALVES _____

OTHER _____

OTHER DISTRIBUTION TYPE

NITRIFICATION LINES

TRENCH WIDTH 3'

TRENCH LENGTH 100'

TRENCH GRADE 0"

STONE DEPTH 12"

COMMENTS:

TO: [illegible]
FROM: [illegible]
SUBJECT: [illegible]

[illegible text block]

[illegible text block]

Large Layout on Back 11:30 A.M. Thursday May 4th 2061

PERMIT NUMBER 2061

File

GRANVILLE - VANCE DISTRICT HEALTH DEPARTMENT IMPROVEMENT AND OPERATION PERMITS

COUNTY:	TAX NO. 08740 1452167	TYPE OF ESTABLISHMENT			*THIS PERMIT SHALL BE ACCOMPANIED BY A LAYOUT SHOWN ON A PLAT, INCLUDING SYSTEM REQUIREMENTS.
Granville	SIR NO. 1726	RESIDENCE ☒ BUSINESS ☐ OTHER ☐	NUMBER OF BEDROOMS: 3	NUMBER OF OCCUPANTS:	
OWNER: John Thompson					
APPLICANT: John Thompson		WATER SUPPLY			
APPLICANT'S ADDRESS: 2207 Rode Drive Durham, NC 27703		PUBLIC ☐	WELL ☒	OTHER ☐	*THE IMPROVEMENTS PERMIT MUST BE ATTACHED TO A CONSTRUCTION AUTHORIZATION BEFORE OBTAINING BUILDING PERMIT OR OTHER CONSTRUCTION PERMITS AND BEFORE A WASTEWATER SYSTEM IS INSTALLED.
PROPERTY ADDRESS/LOCATION: Will Smith Rd.		TYPE OF WASTEWATER SYSTEM			
		DESCRIPTION	INITIAL ☒ INSTALLATION	REPAIR	
SUBDIVISION:		DESIGN FLOW:	360 gal/day		
LOT NUMBER:		LTAR:	.4		
REFERENCE SKETCH (SEE PLAT FOR DETAILS) See sketch on back. Dig trenches 18"-24" deep level on contour. Stay at least 5' from house, 10' from property line, & 100' from any well. Do not install or call for inspection in rain.		ABSORPTION AREA:	900 sq. ft.		
		TRENCH WIDTH:	3'		
		TRENCH SPACING:	9' on center		
		TOTAL TRENCH LENGTH:	300 ft.		
		NUMBER OF TRENCHES:	3		
		GRAVEL DEPTH:	12"		
		TANK SIZE:	1000 gal.		
		CONDITIONS:			*THIS IMPROVEMENT PERMIT IS SUBJECT TO REVOCATION IF THE INTENDED USE CHANGE FROM THOSE SHOWN ON THE IMPROVEMENT PERMIT. CHANGES SHALL REQUIRE HEALTH DEPARTMENT APPROVAL.
IMPROVEMENT PERMIT		DATE:			
FOR: John Thompson ISSUED BY: M.E. Zount R.		8-12-99			
OPERATION PERMIT		DATE:			
SYSTEM INSTALLED BY: Leonard O'Briant ISSUED BY: M.E. Zount		5-4-00			

WELL CONSTRUCTION RECORD (GW-1)**1. Well Contractor Information:**Felton Jacobs

Well Contractor Name

2765-A

NC Well Contractor Certification Number

UpFront

Company Name

2. Well Construction Permit #: 382413

List all applicable well construction permits (i.e. UTC, County, State, Variance, etc.)

3. Well Use (check well use):**Water Supply Well:**

- ☐ Agricultural ☐ Municipal/Public
☐ Geothermal (Heating/Cooling Supply) ☒ Residential Water Supply (single)
☐ Industrial/Commercial ☐ Residential Water Supply (shared)
☐ Irrigation ☐ Wells > 100,000 GPD

Non-Water Supply Well:

- ☐ Monitoring ☐ Recovery

Injection Well:

- ☐ Aquifer Recharge ☐ Groundwater Remediation
☐ Aquifer Storage and Recovery ☐ Salinity Barrier
☐ Aquifer Test ☐ Stormwater Drainage
☐ Experimental Technology ☐ Subsidence Control
☐ Geothermal (Closed Loop) ☐ Tracer
☐ Geothermal (Heating/Cooling Return) ☐ Other (explain under #21 Remarks)

4. Date Well(s) Completed: 4-15-23 Well ID# _____**5a. Well Location:**Rebecca Davis

Facility/Owner Name

Facility ID# (if applicable)

1115 Will Suit Ad

Physical Address, City, and Zip

Granville

County

Parcel Identification No. (PIN)

5b. Latitude and longitude in degrees/minutes/seconds or decimal degrees:
(if well field, one lat/long is sufficient)

_____ N _____ W

6. Is(are) the well(s): ☒ Permanent or ☐ Temporary**7. Is this a repair to an existing well:** ☐ Yes or ☒ No

If this is a repair, fill out known well construction information and explain the nature of the repair under #21 remarks section or on the back of this form.

8. For Geoprobe/DPT or Closed-Loop Geothermal Wells having the same construction, only 1 GW-1 is needed. Indicate TOTAL NUMBER of wells drilled: _____**9. Total well depth below land surface:** 304 (ft.)
For multiple wells list all depths if different (example- 3@200' and 2@100')**10. Static water level below top of casing:** 20 (ft.)
If water level is above casing, use "+"**11. Borehole diameter:** 6 (in.)**12. Well construction method:** Rotary
(i.e. auger, rotary, cable, direct push, etc.)**FOR WATER SUPPLY WELLS ONLY:****13a. Yield (gpm)** 10 Method of test: Blow**13b. Disinfection type:** H7H Amount: 1lb

For Internal Use Only:

14. WATER ZONES

FROM	TO	DESCRIPTION
ft.	<u>260</u> ft.	<u>10' down</u>
ft.	ft.	

15. OUTER CASING (for multi-cased wells) OR LINER (if applicable)

FROM	TO	DIAMETER	THICKNESS	MATERIAL
<u>1</u> ft.	<u>60</u> ft.	<u>6</u> in.	<u>188</u>	<u>Galv</u>

16. INNER CASING OR TUBING (geothermal closed-loop)

FROM	TO	DIAMETER	THICKNESS	MATERIAL
ft.	ft.	in.		
ft.	ft.	in.		

17. SCREEN

FROM	TO	DIAMETER	SLOT SIZE	THICKNESS	MATERIAL
ft.	ft.	in.			
ft.	ft.	in.			

18. GROUT

FROM	TO	MATERIAL	EMPLACEMENT METHOD & AMOUNT
<u>0</u> ft.	<u>20</u> ft.	<u>Hole plug</u>	<u>poured</u>
ft.	ft.		
ft.	ft.		

19. SAND/GRAVEL PACK (if applicable)

FROM	TO	MATERIAL	EMPLACEMENT METHOD
ft.	ft.		
ft.	ft.		

20. DRILLING LOG (attach additional sheets if necessary)

FROM	TO	DESCRIPTION (color, hardness, soil/rock type, grain size, etc.)
<u>0</u> ft.	<u>3</u> ft.	<u>Top soil</u>
<u>3</u> ft.	<u>20</u> ft.	<u>clay</u>
<u>20</u> ft.	<u>50</u> ft.	<u>sand</u>
<u>50</u> ft.	<u>285</u> ft.	<u>granite</u>
ft.	ft.	
ft.	ft.	
ft.	ft.	

21. REMARKSSteel Hordon Drive Shoe**22. Certification:**Felton Jacobs
Signature of Certified Well Contractor4-15-23
Date

By signing this form, I hereby certify that the well(s) was (were) constructed in accordance with 15A NCAC 02C .0100 or 15A NCAC 02C .0200 Well Construction Standards and that a copy of this record has been provided to the well owner.

23. Site diagram or additional well details:

You may use the back of this page to provide additional well construction info (add 'See Over' in Remarks Box). You may also attach additional pages if necessary.

24. SUBMITTAL INSTRUCTIONS

Submit this GW-1 within 30 days of well completion per the following:

24a. For All Wells: Original form to Division of Water Resources (DWR), Information Processing Unit, 1617 MSC, Raleigh, NC 27699-1617**24b. For Injection Wells:** Copy to DWR, Underground Injection Control (IUC) Program, 1636 MSC, Raleigh, NC 27699-1636**24c. For Water Supply and Open-Loop Geothermal Return Wells:** Copy to the county environmental health department of the county where installed**24d. For Water Wells producing over 100,000 GPD:** Copy to DWR, CCPCUA Permit Program, 1611 MSC, Raleigh, NC 27699-1611