

SEWAGE DISPOSAL SYSTEM INSTALLATION REVIEW

SEPTIC AND PUMP TANK INSPECTION

SEPTIC TANK

Manufacturer DB
 Date of Manufacture 9/1/20
 Stamp STD-324
 Capacity 1000
 Tee /
 Baffle /
 Sealant /
 AIR GAP /, FILTER /, RISER /

INITIAL

WTB
/
/
DATE

2-23-21
/
/
PUMP TANK

Manufacture _____
 Date of Manufacture _____
 Stamp _____
 Capacity _____
 Sealant _____
 Manhole _____
 RISER _____, SEALANT _____

MECHANICAL INSPECTION

PUMP

Manufacturer and Model # _____
 Control Panel _____
 Alarm _____
 Electrical Connection _____
 SEALANT AROUND CONDUIT _____

NITRIFICATION/DISTRIBUTION AND DRAINFIELD INSPECTION

DISTRIBUTION BOX

Level /
 Equal Distribution /
 Other _____

WTB
/
/

2-23-21
/
/

DISTRIBUTION MANIFOLD

Pipe Size _____
 Gate Valves _____
 Other _____

OTHER DISTRIBUTION

Type _____

NITRIFICATION LINES

Trench Width
 Trench Length
 Trench Grade
 Stone Depth

LINE 1

3'
110'
/
18"

LINE 2

2'
110'
/
18"

LINE 3

3'
110'
/
20"

LINE 4

3'
110'
/
22"

LINE 5

LINE 6

EZ flow

WELL INSPECTION

LOCATION OF WELL No well yet

WTB

2-23-21

COMMENTS:

N-6-EZ1203NGED

W2 tags ✓ / Elec box ✓ / vent ✓ / sight ✓
12" ✓ / holes sealed ✓

Granville – Vance District Health Department
Environmental Health

Pin _____

Permit Number 328398

Final Sketch

Sumner Const.

Applicants Name

Ironwood 199

Subdivision – Section – Lot

Physical Address: 3800 Westmark Dr.


Number of Bedrooms 4


Trucworks

System Installer

2-23-21

Date

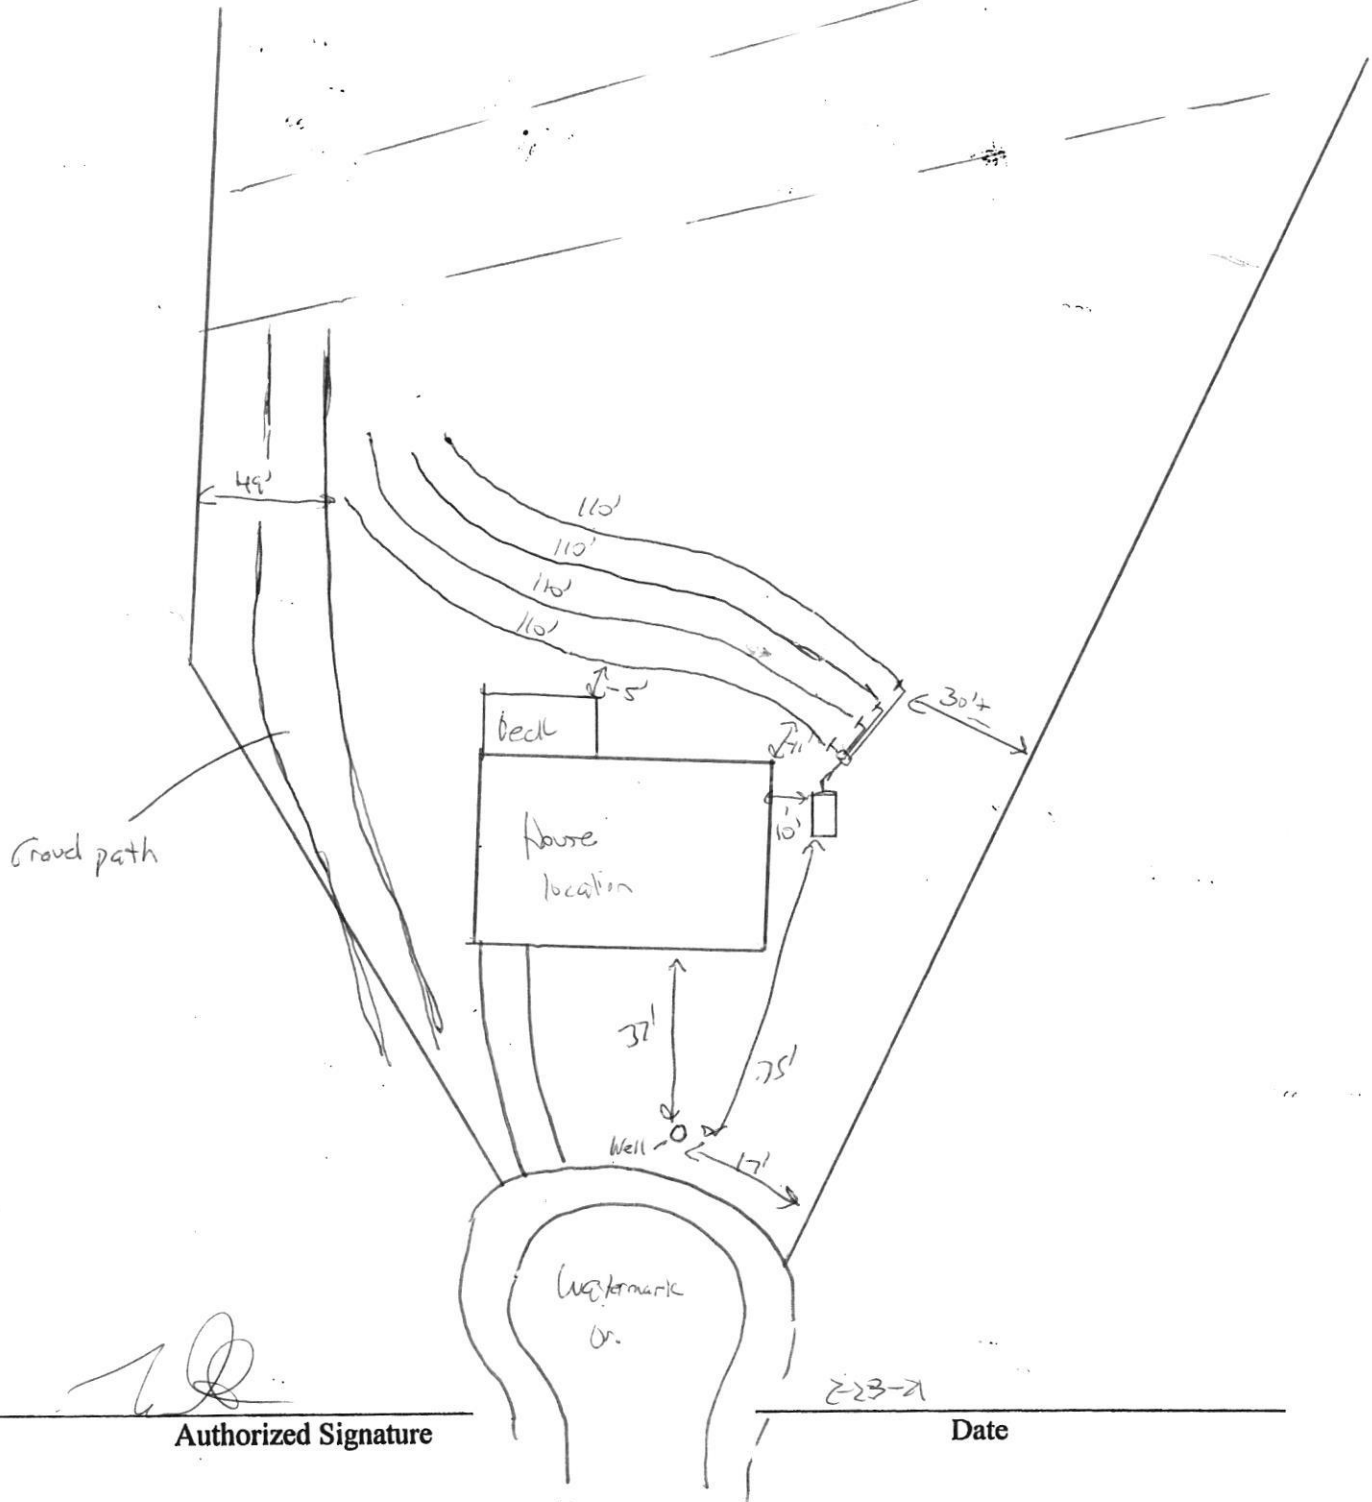

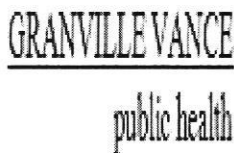

Construction Authorization

Granville County Health Dept

Environmental Health

101 Hunt Drive

Oxford, NC 27565

Phone: (252) 492-5263 Fax: (252) 492-2361

For Office Use Only

*CDP File Number: 328398 - 1

County ID Number: 182500642760

Evaluated For: NEW

PERMIT VALID UNTIL: 08/13/2025

☐ Open Pump System Sheet

Applicant: Sumner Construction

Address: PO Box 1011

City: Youngsville

State/Zip: NC 27596

Phone #: home: (919) 422-5713

Property Owner: Ironwood Investements

Address: 3800 Watermark Dr

City: Youngsville

State/Zip: NC. 27596

Phone #: home: (919) 422-5713

Property Location & Site Information

Address/Road #: 3800 Watermark Dr
Franklinton, NC 27525

Subdivision: Ironwood Phase: NEW Lot: 199

Directions:

Structure: SINGLE FAMILY Ironwood

of Bedrooms: 4

of People:

*Water Supply: NEW WELL

System Specifications

*Site Classification: Provisionally Suitable

Design Flow: 480

Soil Application Rate: 0.2750

Minimum Trench Depth: _____ Inches

Maximum Trench Depth: 18 Inches

Minimum Soil Cover: _____ Inches

Maximum Soil Cover: _____ Inches

*System Classification/Description:

TYPE III G. OTHER NON-CONV. TRENCH SYSTEMS

*Proposed System:

25% REDUCTION

*Distribution Type: GRAVITY - SERIAL

Nitrification Field: 1309 Sq. ft.

No. Drain Lines: 1

Total Trench Length: 440 ft.

Trench Spacing: 9 - _____

Trench Width: 3 - _____

Aggregate Depth: _____ inches

☐ Inches O.C.

☒ Feet O.C.

☐ Inches

☒ Feet

Pump Required: ☐ Yes ☒ No ☐ May Be Required

Pump Tank: _____ Gallons

Grease Trap: _____ Gallons

Septic Tank Installer

Grade Level Required: ☐ I ☒ II ☐ III ☐ IV

The issuance of this permit by the Health Department in no way guarantees the issuance of other permits. The permit holder is responsible for checking with appropriate governing bodies in meeting their requirements.

*Permit Conditions:

System (Initial/Repair) laid out in field by REHS/Drainlines min. 10' off property lines/Stay off 20' drainage easement and 50' PSNC easement with any part of septic/50' min. off all well's/Serial Distribution system

The Authorization for Wastewater System Construction shall be valid for a period equal to the period of validity of the Improvement Permit and may be issued at the same time the Improvement Permit issued (NCGS 130A-336(b)). If the installation has not been completed during the period of validity of the Construction Permit, the information submitted in the application for a permit or Construction Authorization shall become invalid, and may be suspended or revoked (.1937(g)). The person owning or controlling the system shall be responsible for assuring compliance with the laws, rules, and permit conditions regarding system location, installation, operation, maintenance, monitoring, reporting

Authorized State Agent: Bullock, Will

Date of Issue: 08/13/2020

☒ Hand Drawing

☐ Import Drawing

Site Plan/Drawing attached.

Total Time : (HH:MM) _____