

GRANVILLE-VANCE HEALTH DEPARTMENT—Sewage Disposal Record

Owner or Contractor Dorsey Homes Date 9-12-08 R. No. 1705

Location/Address Tenney Dr.

Subdivision/Mobile Home Park Name Starnett Forest Lot Size 10

Permit No. # 6317 Lot No. 10

New System ☒ Repair ☐

House ☒ Mobile Home ☐ Business ☐

No. Bedrooms 3 No. People 3 No. Toilets 3

Water Supply: Private ☒ Approved ☐

Semi-Public ☐ Unapproved ☐

Public ☐ None ☐

Nitrification System:

Tank Size 1000 gal. PT 1000 gal

~~Retention Basin~~ No. Lines 4

Nitrification Field 900 Sq. Ft.

Lines:

1'	2'	3'	4'	5'	6'
----	----	----	----	----	----

Width 3' 3' 3' 3' 3' 3'

Length 25' 25' 25' 25' 25' 25'

Grade 0" 0" 0" 0" 0" 0"

Stone Depth E-2-FLW


Layout to be followed by installer:

Improvements Permit By Jimmy B. Cline Installer Robert Barclay

Certificate of Completion By Robert Barclay Date of Inspection 9-12-07

* Construction must comply with all other applicable state and local regulations, but the permit is not a guarantee that the system will not malfunction and the Granville-Vance Health District will not be held responsible for a malfunctioning system.

NOTE: Make sketch of installation showing location of house, septic tanks, privies, water supplies on adjacent property, etc. Write in measurements in order that installations may be located at later date.

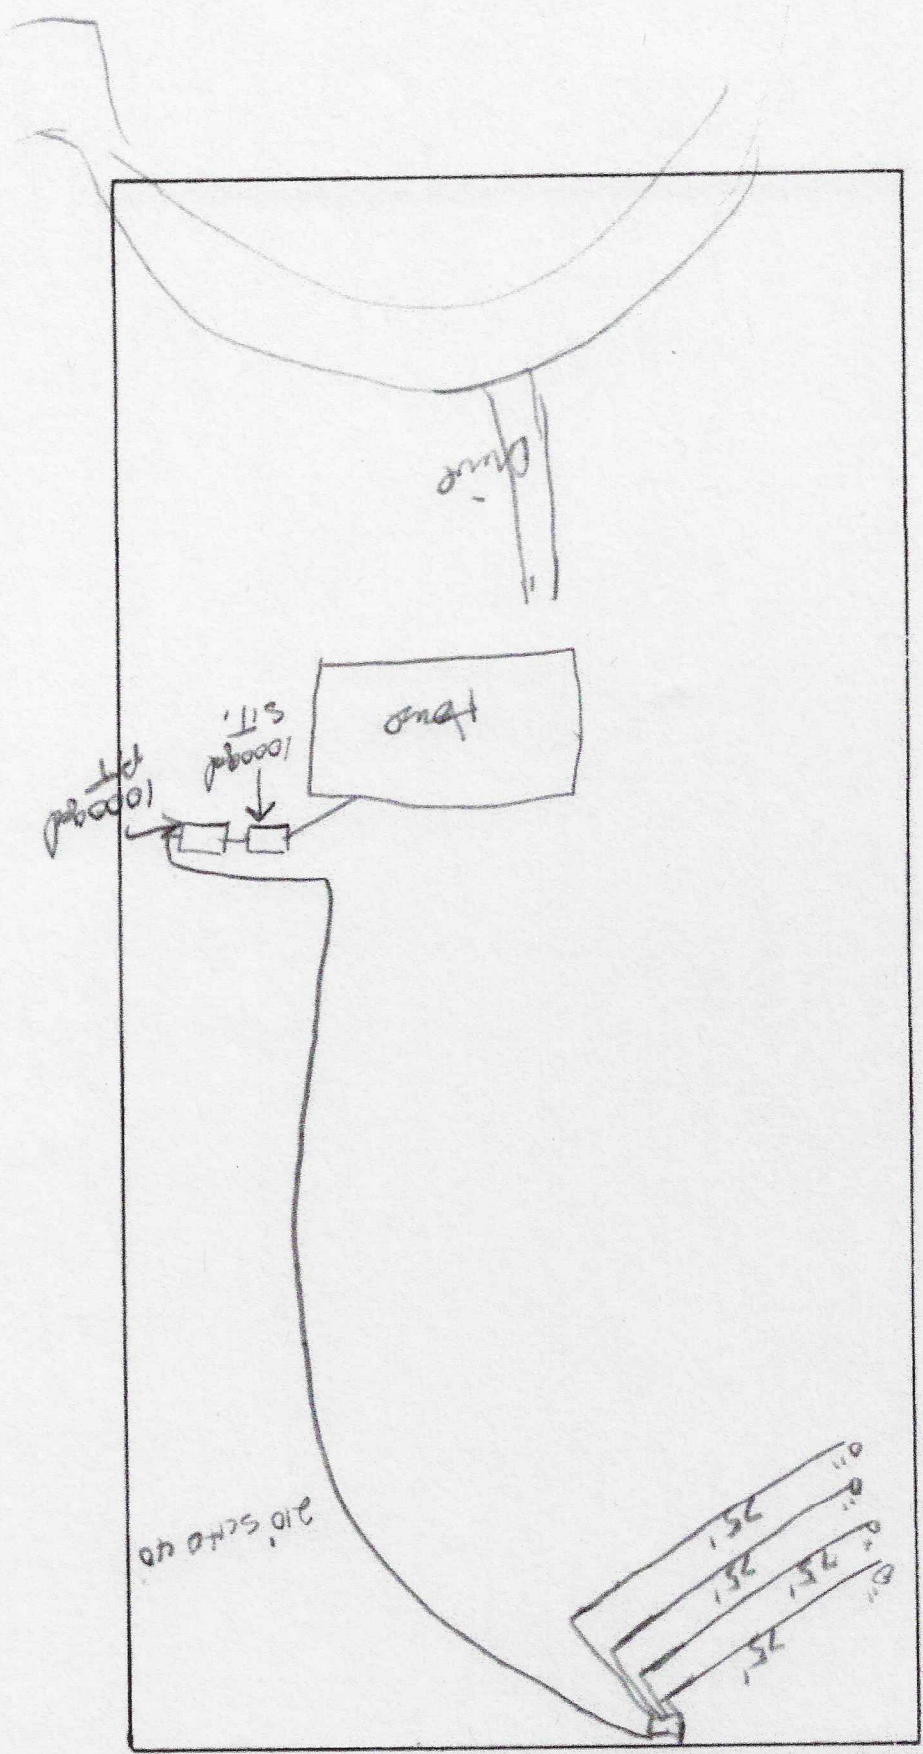

Not to scale