



Granville-Vance District Health Department

Lisa M. Harrison, MPH, Health Director
Post Office Box 367
Oxford, North Carolina 27565



Granville County Health Dept.
101 Hunt Drive
Oxford, NC 27565
Phone: (919) 693-2688
Fax: 919-690-0106

Vance County Health Dept.
115 Charles Rollins Road
Henderson, NC 27536
Phone: (252) 492-7915
Fax: (252) 492-4219

Recertification of an Existing On-Site System and Well

Owner Name / Applicant Name: North Miller Date: 8-6-15
Physical Address: 115 Charles Rollins Road Contact Number: 252-492-7915
Subdivision: Granville Lot #: 1 Zoning Permit #: 115-1

Septic Permit #: 115-1 Date Installed: 10-1-07

Recertification Of: 1 Bedrooms Allowed

Existing House Replacement: Size: 115-1

Pool: 1 - Size: 115-1
Septic Redesign/Upgrade: 115-1
Permit #: 115-1

Addition to House: 1 - Size: 115-1
Bedroom Addition: 115-1 Septic Upgrade: 115-1
Permit #: 115-1 New Well: 115-1

Outbuilding Addition: 1 - Size: 115-1

Other Additions to Property: 115-1

1 Setbacks have been met accordingly at this time.

1 Onsite Wastewater System is functioning properly at this time.

1 Onsite Wastewater System is functioning properly at this time, but system upgrade is required.
Permit #: 115-1

*** System Upgrade must be completed prior to Certification of Occupancy.

1 Onsite Wastewater System is **NOT** functioning properly at this time.

Repair Permit #: 115-1

*** System repair must be completed prior to Certification of Occupancy.

Recertification denied, due to: 115-1

Cannot determine due to: 115-1

Special Instructions: 115-1

115-1
Signature of REHS

8-6-15
Date

GRANVILLE-VANCE HEALTH DEPARTMENT—Sewage Disposal Record

Owner or Contractor Tunstall / Wynn Date 10-31-05 S.R. No. 1126

Location/Address Rauge Road

Subdivision/Mobile Home Park Name Reels Creek Lot Size 1.524 acs

Permit No. # 3860 Lot No. 6

New System ☒ Repair ☐

House ☒ Mobile Home ☐ Business ☐

No. Bedrooms 3 No. People 3 No. Toilets 3

Water Supply: Private ☒ Approved ☐

Semi-Public ☐ Unapproved ☐

Public ☐ None ☐

Nitrification System:

Tank Size 1000 gal. 4

Distribution Box 1 No. Lines 4

Nitrification Field 1300 Sq. Ft.

Lines:

1'	2'	3'	4'	5'	6'
----	----	----	----	----	----

Width 3' 3' 3' 3' 3' 3'

Length 85' 103' 103' 110' 110' 110'

Grade 0' 0' 0' 0' 0' 0'

Stone Depth 12" 12" 12" 12" 12" 12"


Layout to be followed by installer:

Improvements Permit By David Cumber Installer Robert Blalock

Certificate of Completion By Eddie Young Date of Inspection 10-31-05

* Construction must comply with all other applicable state and local regulations, but the permit is not a guarantee that the system will not malfunction and the Granville-Vance Health District will not be held responsible for a malfunctioning system.

NOTE: Make sketch of installation showing location of house, septic tanks, privies, water supplies on adjacent property, etc. Write in measurements in order that installations may be located at later date.

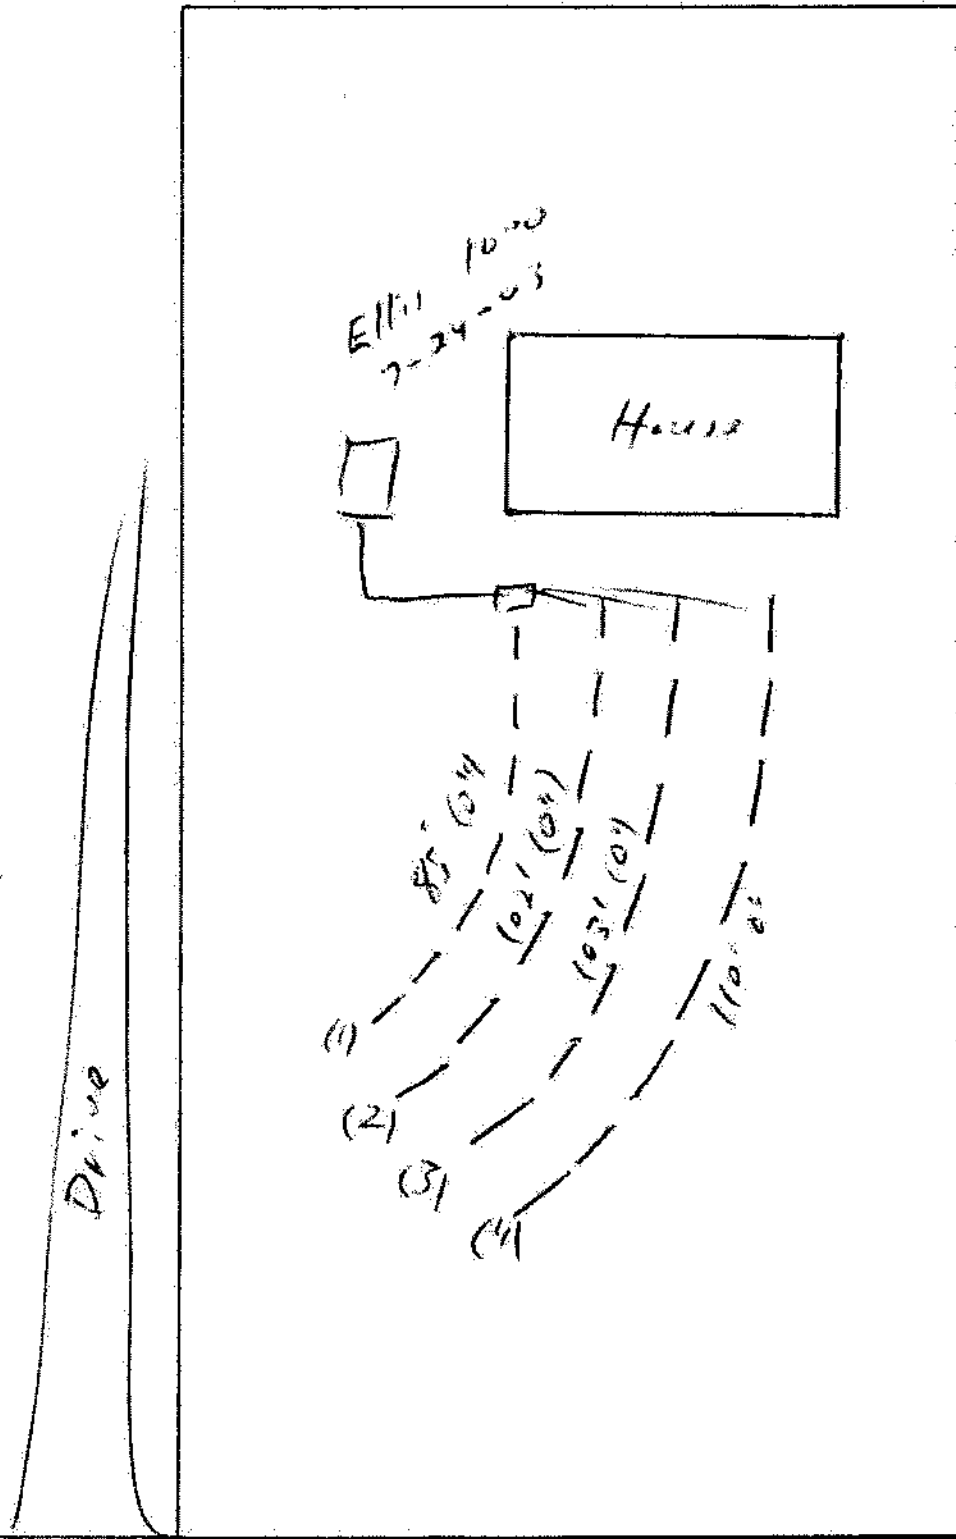

Range Rd. SR 1126