


* No well at time
ST installed

NOTE: Make sketch of installation showing location of house, septic tanks, privies, water supplies on adjacent property, etc. Write in measurements in order that installations may be located at later date.

① 100 1 3/2"

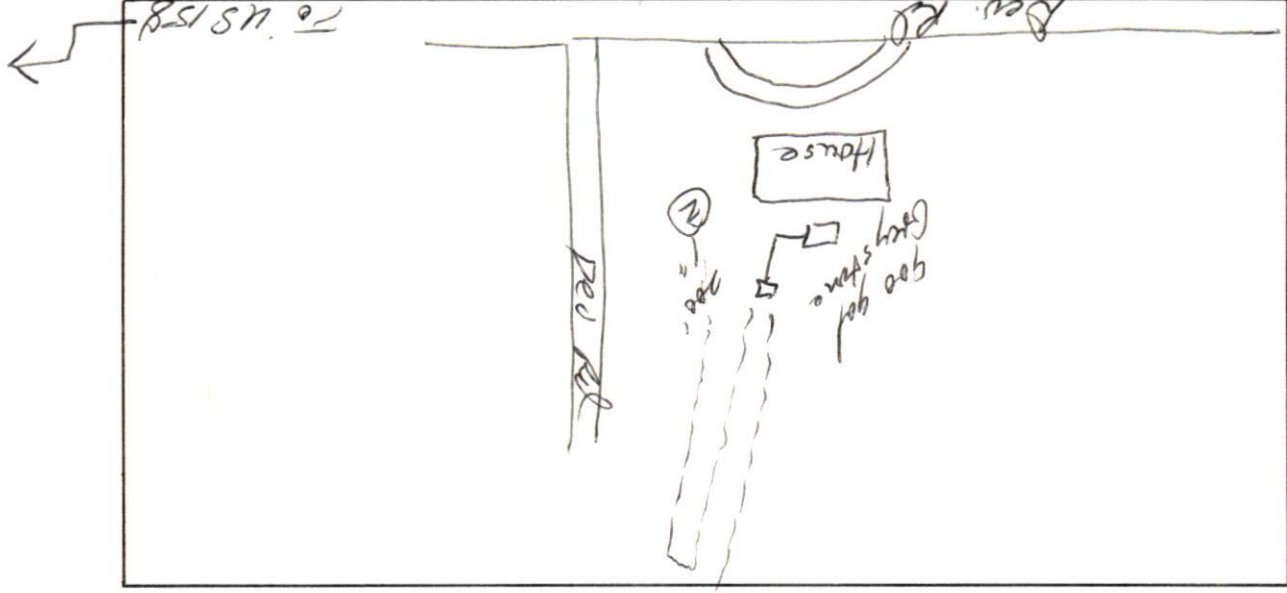

To US 158

Rd 20

② 100 1 3/2"

1226

GRANVILLE-VANCE HEALTH DEPARTMENT—Sewage Disposal Record

Owner or Contractor Norman Corsett Date 11-21-88 S.R. No. 11584
Location/Address Rt. 1 Oxford N.C.
Subdivision/Mobile Home Park Name Shelton Hills Lot Size 1Ac
Lot No. 31

New System ☒ Repair _____
House ☒ Mobile Home _____ Business _____
No. Bedrooms 3 No. People Not sale No. Toilets 2
Water Supply: Private ☒ Approved _____
Semi-Public _____ Unapproved _____
Public _____ None _____

Nitrification System:

Tank Size 900 gal.
Distribution Box yes No. Lines 2
Nitrification Field 320' - 460' Sq. Ft.
Lines: 1 2 3 4 5 6
Width 3' 3' ____ ____ ____ ____
Length 120' 200' ____ ____ ____ ____
Grade 3 1/2" 1" ____ ____ ____ ____
Stone Depth 12" 12" ____ ____ ____ ____

Layout to be followed by installer:

Improvements Permit By Charles R. Nobley Installer Norman Corsett
Certificate of Completion By Charles R. Nobley Date of Inspection 12-29-88

* Construction must comply with all other applicable state and local regulations, but the permit is not a guarantee that the system will not malfunction and the Granville-Vance Health District will not be held responsible for a malfunctioning system.