


Good

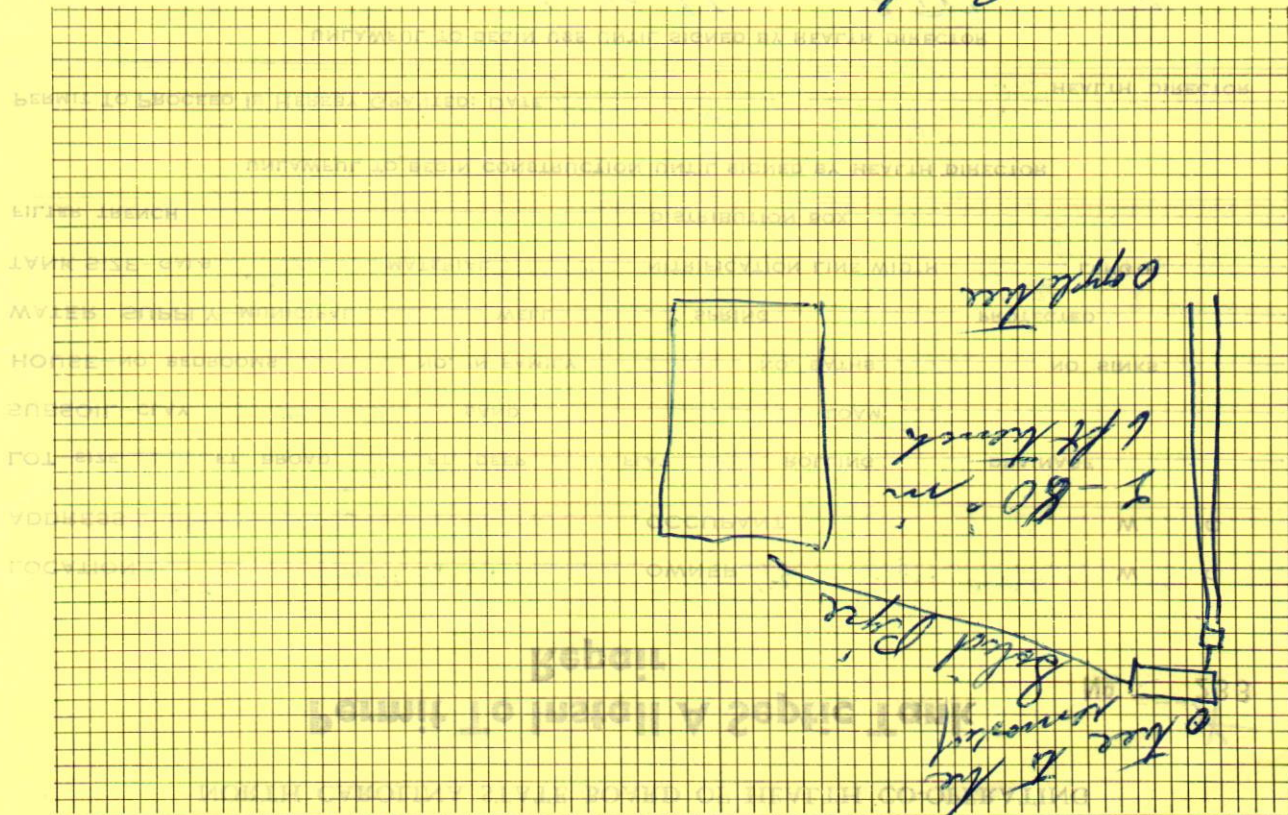

GRANVILLE COUNTY HEALTH DEPARTMENT
NORTH CAROLINA STATE BOARD OF HEALTH CO-OPERATING

Permit To Install A Septic Tank Repair

№ 233

LOCATION 15th 1 mile OWNER W B Brooks W ☒ C ☐
ADDRESS 9 doors from garage OCCUPANT _____ W ☐ C ☐
LOT-SIZE _____ FT. BROAD 100 FT. DEEP 200 FLAT ☒ ROLLING _____ DRAINAGE _____
SUBSOIL-CLAY ☒ SAND _____ LOAM _____
HOUSE-NO. BEDROOMS 2 NO. IN FAMILY 4 NO. BATHS 1 NO SINKS 1
WATER SUPPLY-MUNICIPAL _____ WELL ☒ SPRING _____ PROTECTED _____
TANK SIZE-GALS. 900 MATERIAL concrete NITRIFICATION LINE WIDTH 6 ft - 2-50 ft LENGTH _____
FILTER TRENCH _____ DISTRIBUTION BOX total 160

UNLAWFUL TO BEGIN CONSTRUCTION UNTIL SIGNED BY HEALTH DIRECTOR

PERMIT TO PROCEED IS HEREBY GRANTED: DATE 1-5-66 B. B. Branch
BB HEALTH DIRECTOR

UNLAWFUL TO BEGIN USE UNTIL SIGNED BY HEALTH DIRECTOR

PERMIT TO USE IS HEREBY GRANTED: DATE 1-13-66 B T Branch
HEALTH DIRECTOR