

GRANVILLE-VANCE DISTRICT HEALTH DEPARTMENT IMPROVEMENT AND OPERATION PERMITS

COUNTY: <u>Granville</u>	TAX NO. <u>187500851865</u>	TYPE OF ESTABLISHMENTS			*THIS PERMIT SHALL BE ACCOMPANIED BY A LAYOUT SHOWN ON A PLAT, INCLUDING SYSTEM REQUIREMENTS. *THIS IMPROVEMENT PERMIT IS SUBJECT TO REVOCATION IF THE INTENDED USES CHANGE FROM THOSE SHOWN ON THE IMPROVEMENT PERMIT. CHANGES SHALL REQUIRE HEALTH DEPARTMENT APPROVAL.
	SR. NO.	RESIDENCE ☒ BUSINESS ☐ OTHER ☐	NUMBER OF BEDROOMS: <u>4</u>	NUMBER OF OCCUPANTS: <u>8 MAX</u>	
APPLICANT: <u>AVH Construction</u>	WATER SUPPLY	WELL ☒ PUBLIC ☐	OTHER ☐		
APPLICANT'S NAME & ADDRESS:	TYPE OF WASTEWATER SYSTEM	INITIAL INSTALLATION <u>Type IIIg</u>	REPAIR		
PROPERTY ADDRESS/LOCATION: <u>1723 River Club Way</u>	DESIGN FLOW:	<u>480 gpc</u>			
SUBDIVISION: <u>Ironwood</u>	LTAR:	<u>.3 gpc/ft²</u>			
LOT NUMBER: <u>45</u>	ABSORPTION AREA:	<u>1,200 ft²</u>			
REFERENCE SKETCH (SEE PLAT FOR DETAILS) * <u>Do Not</u> install in wet soils. * maintain setbacks	TRENCH WIDTH:	<u>36"</u>			
	TRENCH DEPTH:	<u>24-26"</u>			
	TRENCH SPACING:	<u>9' o.c.</u>			
	TOTAL TRENCH LENGTH:	<u>400'</u>			
	NUMBER OF TRENCHES:	<u>4</u>			
	GRAVEL DEPTH:	<u>N/A</u>			
	TANK SIZE:	<u>1000 gal</u>			
	PUMP TANK SIZE:	<u>N/A</u>			
	DISTRIBUTION DEVICE:	<u>D-Box</u>			PERMIT VALID FOR 5 YEARS YES ☒ NO ☐
					NO EXPIRATION YES ☐ NO ☒

IMPROVEMENT PERMIT

 DATE: 6-23-17

FOR:

AVH Carolinas

ISSUED BY:

Glenn Curran

CONSTRUCTION AUTHORIZATION FOR IMPROVEMENT PERMIT#

9135

Unless otherwise indicated, the same conditions above apply regarding system type, layout, location and installation requirement.
(The wastewater system cannot be installed until authorization is signed)

Comments:

Date:

6-23-17

Environmental Health Specialist:

Glenn Curran

Construction Authorization Addendum

☒ Yes ☐ No

OPERATION PERMIT

 DATE: 12-29-17

SYSTEM INSTALLED BY:

Glenn Todd

ISSUED BY:

Glenn Curran

PERFORMANCE, MONITORING, MAINTENANCE AND OPERATION
AS REQUIRED BY RULE .1961

Granville-Vance District Health Department

Environmental Health

PIN _____

Final Sketch

Date 12-29-17

AV Homes

Applicant's Name

9135

Permit No.

Ironwood/45

Subdivision/Lot Number


Glenn Todd

System Installer

Physical Address: 1773 River club way

Glenn Todd

Authorized Signature

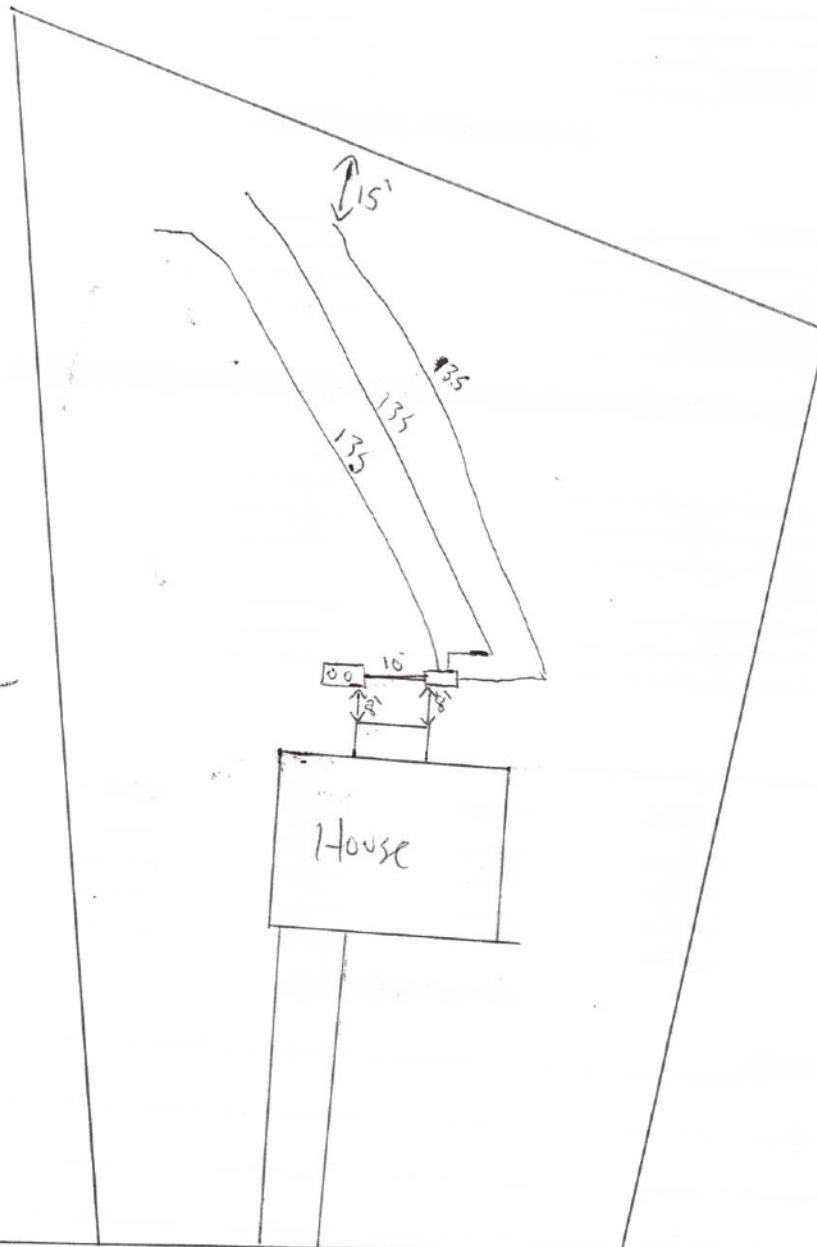

River club way