



NOTICE TO APPLICANT AND HEALTH/INSPECTION DEPTS.

Any changes made to this drawing/ plat or to the physical siting of the structure or use herein permitted without written approval from the Granville County Planning Department shall render this Zoning Permit void and subject to legal action per Section VIII-2, VIII-4 of the Granville County Zoning Ordinance.

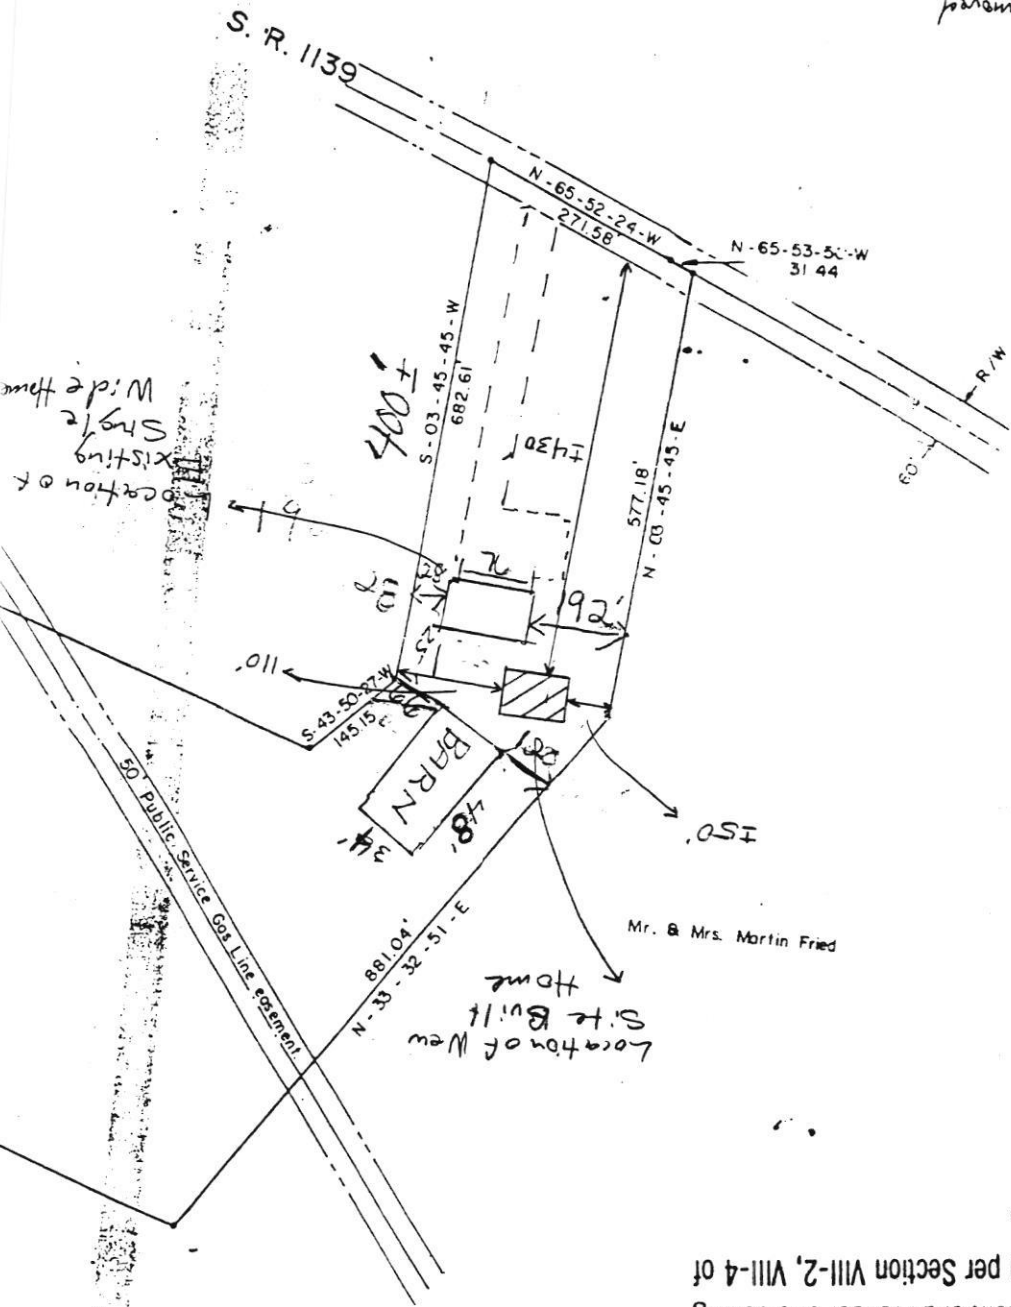

1 inch = 200 feet

* Existing Single Wide to be removed after completion of Site Build Home.

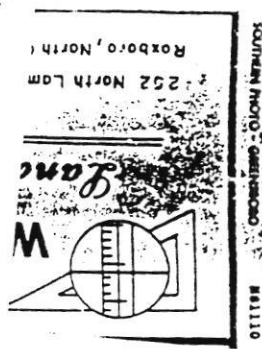



COUNTY OF GRANVILLE, NORTH CAROLINA

122 WILLIAMSBORO STREET, POST OFFICE BOX 877, OXFORD, NORTH CAROLINA 27565

TELEPHONE (919) 603-1331

FAX (919) 603-0535

ZONING PERMIT # **6512**

existing app

Owner as on tax records Robert M. & Carol A. Perunko	Mailing Address 181 Euon Rd. Oxford, NC 27565	Telephone No. (919) 603-0456
Applicant (Same)	Mailing Address (Same)	Telephone No. (Same)

Tax Map No. 0950-00	Parcel No. 97-0838	Township Tilly Ho	Road Name and Number Euon Road # 1139	Zoning WSW-40	
Subdivision	Lot No.	Phase	Lot Size 25 acms	Fee \$20.00	Flood Plain ☐ Yes ☒ No
Proposed Use 72'x54' New Site Built Home	Contact:	Phone	Street Address Euon Road		

Land use indicated is permitted in the zoning district. The following minimum zoning requirements must be met, unless the Heath Department requires more land area or other qualifications are indicated in the remarks.

Lot area 40,000 square feet Front yard depth 50 ft. Corner yard depth 25 ft. Aggregate both sides _____
Lot width 100 feet Side yard depth 15 ft. Rear yard depth 25 ft.

I certify that all of the statements made in this application and any attached documents are true, complete and correct to the best of my knowledge and belief and are made in good faith. I understand that false information may be grounds for rejection of this application. Authorized County Representatives are granted right of entry to make evaluations or inspections and to release information upon public request.

Robert M. Perunko
Signature of Owner or Authorized Agent

3-31-96

Date

See Attached Sheet for Site Plans

SITE PLAN

→ existing home to be removed after completion of site built home.

Done 3-31-98

M.R. Jy.

O.K.

Form filled out + left at home

New

3Bdrm

3 people

plm to Perunko line

Processed and Approved By *James Thomas* Date 3-31-98

Granville County Planning Dept.

11:00 A.M. Tues Oct 22nd

William Hight

PERMIT NUMBER _____

GRANVILLE - VANCE DISTRICT HEALTH DEPARTMENT IMPROVEMENT AND OPERATION PERMITS

COUNTY:	TAX NO.	TYPE OF ESTABLISHMENT			*THIS PERMIT SHALL BE ACCOMPANIED BY A LAYOUT SHOWN ON A PLAT, INCLUDING SYSTEM REQUIREMENTS.
Granville	SR NO. 1139	RESIDENCE ☒	NUMBER OF BEDROOMS: 4	NUMBER OF OCCUPANTS: 3	
OWNER: Robert Perunko		BUSINESS ☐			
		OTHER ☐			
APPLICANT: Robert Perunko		WATER SUPPLY			*THE IMPROVEMENTS PERMIT MUST BE ATTACHED TO A CONSTRUCTION AUTHORIZATION BEFORE OBTAINING BUILDING PERMIT OR OTHER CONSTRUCTION PERMITS AND BEFORE A WASTEWATER SYSTEM IS INSTALLED.
APPLICANT'S ADDRESS: Pleasant Valley, NY 12569 Rt 1 Box 163 Maple Rd		PUBLIC ☐	WELL ☒	OTHER ☐	
PROPERTY ADDRESS/LOCATION: Enon Road		TYPE OF WASTEWATER SYSTEM			
		DESCRIPTION	INITIAL INSTALLATION ☒	REPAIR	
SUBDIVISION: Crown Forest		DESIGN FLOW:	480 gal./day		
LOT NUMBER:		LTAR:	14		
REFERENCE SKETCH (SEE PLAT FOR DETAILS) See sketch attached. Dig trenches 18"-24" deep (level) on contour. Stay at least 5' from house, 10' from property line, & 100' from any well		ABSORPTION AREA:	1200 sq ft		
		TRENCH WIDTH:	3'		
		TRENCH SPACING:	9' on center		
		TOTAL TRENCH LENGTH:	400 ft		
		NUMBER OF TRENCHES:	3 or 4		
		GRAVEL DEPTH:	12"		
		TANK SIZE:	1000 gal		
		CONDITIONS:			*THIS IMPROVEMENT PERMIT IS SUBJECT TO REVOCATION IF THE INTENDED USE CHANGE FROM THOSE SHOWN ON THE IMPROVEMENT PERMIT. CHANGES SHALL REQUIRE HEALTH DEPARTMENT APPROVAL.
IMPROVEMENT PERMIT			DATE:		
FOR: Robert Perunko			9-23-96		
ISSUED BY: M.S. Yount					
OPERATION PERMIT			DATE:		
SYSTEM INSTALLED BY: William Hight			10-22-96		
ISSUED BY: M.S. Yount					

Hold for zoning

oxford

Enn RS SR 1139

* no well at time
of inspection

Drive

