

Person County

Granville County

Well 1000
3-2-01

House

90'


well
D

Drive

← Enon Rd. SR. 1139

Blue Creek
Lane

NOTE: Make sketch of installation showing location of house, septic tanks, privies, water supplies on adjacent property, etc. Write in measurements in order that installations may be located at later date.

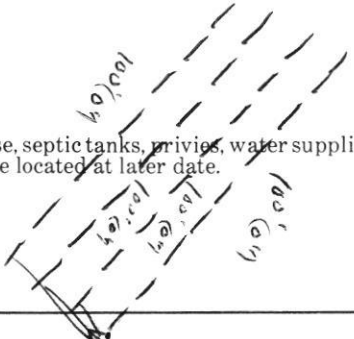

GRANVILLE-VANCE HEALTH DEPARTMENT—Sewage Disposal Record

Owner or Contractor Doug Howell / Randall Shirley Date 4-19-01 S.R. No. 1139
 Location/Address Blue Creek Lane off Enon Rd.
 Subdivision/Mobile Home Park Name Crown Meadows Lot Size 14.88 acres
 Permit No. # 2830 Lot No. 6

New System ☒ Repair _____
 House ☒ Mobile Home _____ Business _____
 No. Bedrooms 3 No. People 3 No. Toilets _____
 Water Supply: Private ☒ Approved _____
 Semi-Public _____ Unapproved _____
 Public _____ None _____

Nitrification System:

Tank Size 1000 gal.
 Distribution Box ☒ No. Lines 4
 Nitrification Field 1200 Sq. Ft.
 Lines: 1 2 3 4 5 6
 Width 3' 3' 3' 3' _____
 Length 100' 100' 100' 100' _____
 Grade 0' 0' 0' 0' _____
 Stone Depth 12" 12" 12" 12" _____

Layout to be followed by installer:

Improvements Permit By Eddie Yount, R.S. Installer Edward Fairson
 Certificate of Completion By Eddie Yount, R.S. Date of Inspection 4-19-01

* Construction must comply with all other applicable state and local regulations, but the permit is not a guarantee that the system will not malfunction and the Granville-Vance Health District will not be held responsible for a malfunctioning system.