


NOTE: Make sketch of installation showing location of house, septic tanks, privies, water supplies on adjacent property, etc. Write in measurements in order that installations may be located at later date.

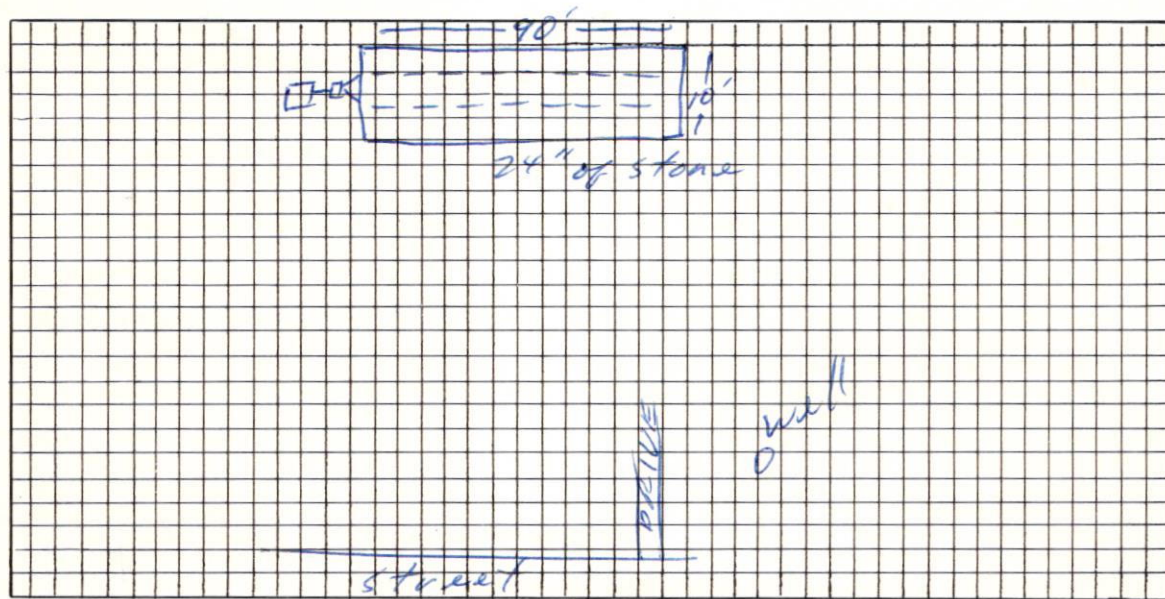

NO. 2514 SEWAGE DISPOSAL RECORD — GRANVILLE COUNTYOwner ☒ Jane L. CareyTenant ☐ _____Subdivision Name Landis HeightsNew System ☒ Repairs ☐ Privy ☐House ☒ Trailer ☐ Business ☐No. Bedrooms 3 Garbage Disposal ☐ Yes ☐ No ☒No. Bathrooms 2 Auto. Dishwasher ☐ Yes ☐ No ☒No. in Family 4 Auto. Washing Machine ☐ Yes ☐ No ☒Water Supply: Individual ☒ Public ☐Lot Area Existing

*Remarks _____

Improvements Permit By Bobby E. GreeneCertificate of Completion By Jane C. ParrottInstalled By Pete EllingtonRPD-Street Rt. 5, Oxford, N.C.SR No. US 158 E.

Lot No. _____ Section or Block No. _____

Nitrification System:

Tank Size 900 Gal.Distribution Box yesNitrification Field 960 Sq. Ft.Nitrification Lines 320' LengthNitrification Line 36" WidthNo. Nitrification Lines 2Stone Depth 12"Grade Boards Yes ☐ No ☒Date Jan. 1980Date 6-27-80