

GRANVILLE-VANCE HEALTH DISTRICT

N^o 2186

(Septic Tank) Improvements Permit & Certificate of Completion

Owner or Contractor Dandy Guston Date July 5, 91 S.R. No. 1159

Location/Address Thad Cones Rd.

Subdivision/Mobile Home Park Name Deer Run Lot Size 2.31 204x204
Lot No. 6, 7, 8

New System ☒ Repair ☐
House ☐ Mobile Home ☐ Business ☐
No. Bedrooms 2 No. People 2 No. Toilets 2
Water Supply: Private ☒ Approved ☐
Semi-Public ☐ Unapproved ☐
Public ☐ None ☒

Nitrification System:
Tank Size 400 gal.
Distribution Box yes No. Lines 2013
Nitrification Field 240 720 Sq. Ft.
Lines: 1 2 3 4 5 6
Width 36" 26"
Length 150 150
Grade 1 3"
Stone Depth 12 12

Layout to be followed by installer:

* Permitted under 1983 Rules
Call Son Layout 693-2678

PERMIT GOOD FOR
5 YEARS FROM
DATE OF ISSUE

Improvements Permit By Bobby E. Dugan Installer Joel Powell

Certificate of Completion By Joel P. Powell Date of Inspection 7-11-91

* Construction must comply with all other applicable state and local regulations, but the permit is not a guarantee that the system will not malfunction and the Granville-Vance Health District will not be held responsible for a malfunctioning system.

GRANVILLE VANCE HEALTH DISTRICT


(Septic Tank) Improvements Permit & Certificate of Completion

Owner or Contractor

Location/Address

Subdivision/Mobile Home Park Name

Barn

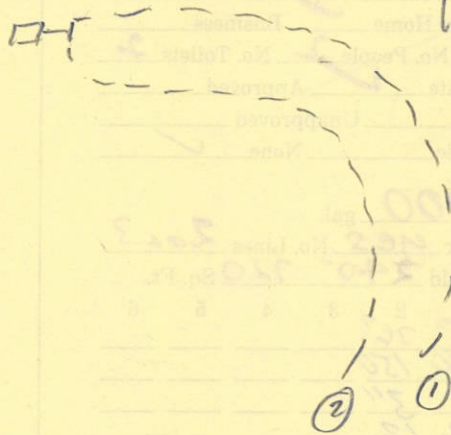

5/11/05

new

PERMIT REQUIRED FOR
3 YEARS FROM
DATE OF ISSUE

Installer

Certificate of Completion By

* Construction must comply with all other applicable state and local regulations but the permit is not a guarantee that the system will not malfunction and the Granville Vance Health District will not be held responsible for a malfunctioning system.