


NOTE: Make sketch of installation showing location of house, septic tanks, privies, water supplies on adjacent property, etc. Write in measurements in order that installation may be located at later date.

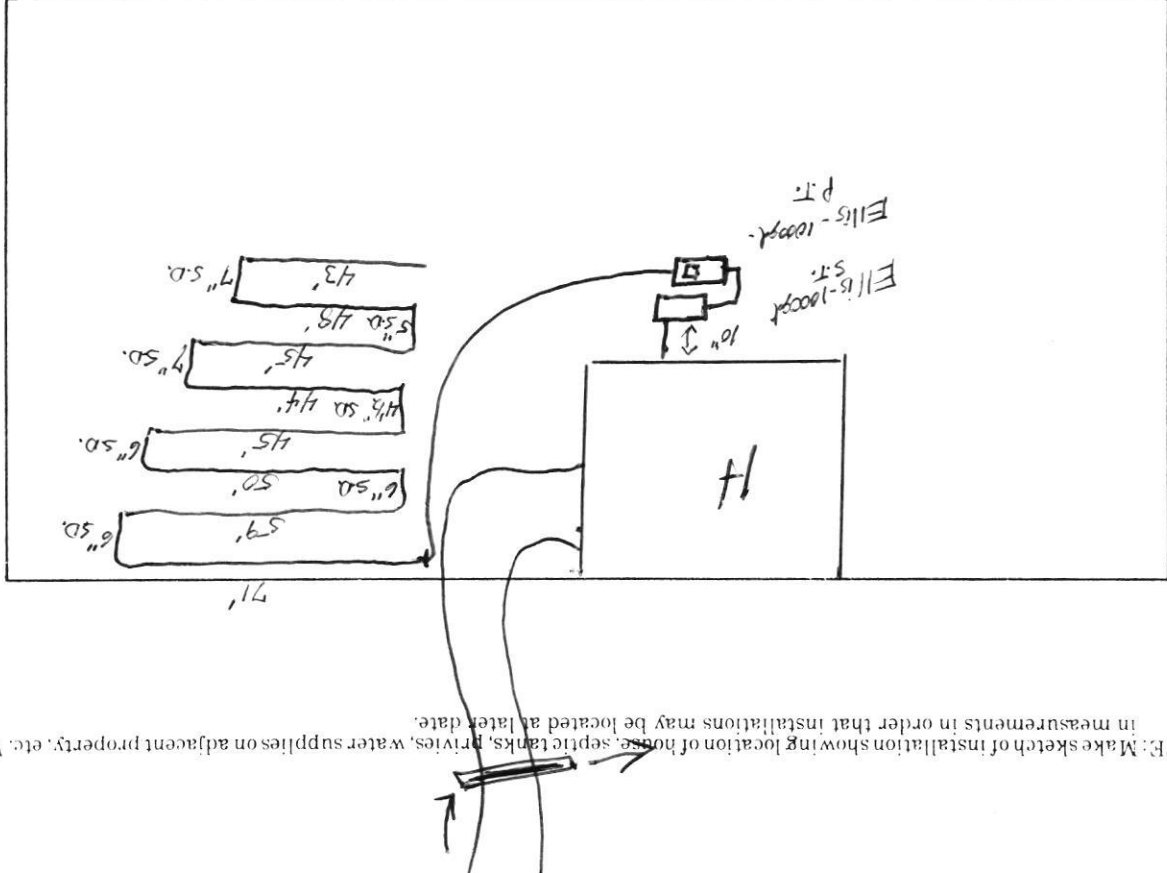

GRANVILLE-VANCE HEALTH DEPARTMENT—Sewage Disposal Record

Owner or Contractor Patrick Williams Date 4-12-05 S.R. No. 1123
 Location/Address Wild Briar Lane
 Subdivision/Mobile Home Park Name Saddle Ridge Lot Size _____
 Permit No. # 4391 Lot No. 15-R

New System ☒ Repair _____
 House ☒ Mobile Home _____ Business _____
 No. Bedrooms 3 No. People _____ No. Toilets _____
 Water Supply: Private ☒ Approved _____
 Semi-Public _____ Unapproved _____
 Public _____ None _____

Nitrification System:

Tank Size 1000 S.T. + 1000 gal P.T. gal.

Distribution Box Serial No. Lines 8

Nitrification Field 1200 Sq. Ft.

Lines:	1	2	3	4	5	6	7	8
Width	3'	3'	3'	3'	3'	3'	3'	3'
Length	71'	59'	50'	45'	44'	45'	48'	43'
Grade	0'6"	0'6"	0'6"	0'4 1/2"	0'7"	0'5"	0'7"	
Stone Depth	12"	12"	12"	12"	12"	12"	12"	12"

Layout to be followed by installer:

** Sketch on back*

Improvements Permit By David Cumber Installer Cole's Backhoe Service
 Certificate of Completion By David Cumber Date of Inspection 11-9-05

* Construction must comply with all other applicable state and local regulations, but the permit is not a guarantee that the system will not malfunction and the Granville-Vance Health District will not be held responsible for a malfunctioning system.