

Pin 181300297978

☒ Improvement Permit

Savvy Homes LLC
Applicant's Name

Applicants Name

Hawthorne 2
Subdivision - Section - Lot

Subdivision – Section – Lot

Physical Address: Hawthorne Place

Blackley Brothers
System Installer

System Installer

1-8-13
Date

Date _____

Date: 6-6-12

Manufacture: Ellis - 12004d

ID #: 5TB-828

Date: _____

Manufacturer: _____

ID #: _____

Distribution Box ✓

Pressure Manifold

Serial Distribution

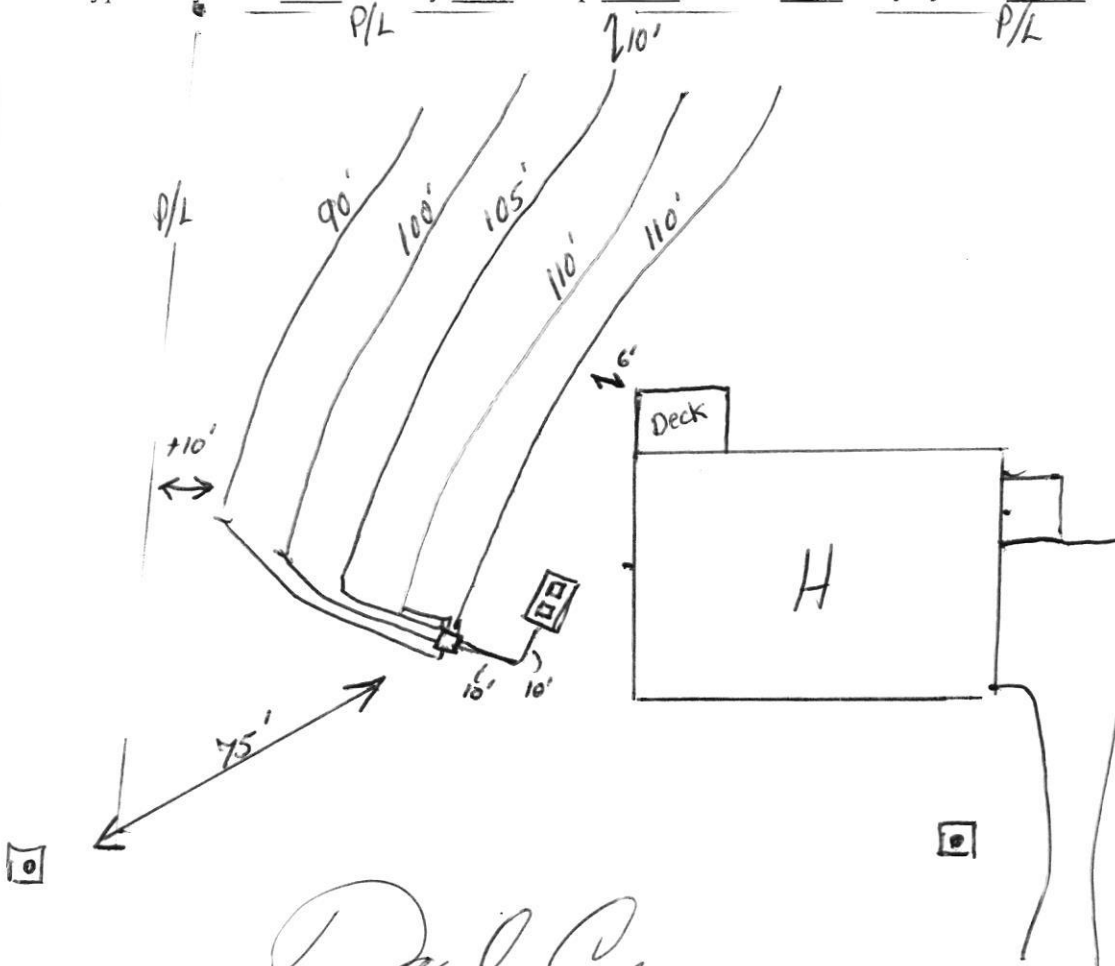
Pump Info:

Type of Facility: *House*

Number of Bedrooms: _____

Type of System: ☒ Gravity ☐ Pump ☐ Gravel ☒ Polystyrene ☐ Chamber ☐ Other: _____

Type of System: ☒ Gravity ☐ Pump ☐ Gravel ☒ Polystyrene ☐ Chamber ☐ Other: _____




Authorized Signature

Authorized Signature

1-11-13

Date _____

Granville - Vance District Health Department

Environmental Health

00793

Well Construction Permit

Owner/Applicant: Savvy HomesDate: 7-13-2012Address or Location of Property: 690 Hawthorne PlaceSubdivision & Lot #: Hawthorne 2Septic Permit #: 7284Zoning Permit #: 17504Environmental Health Specialist: David Rumblee

This well permit is to locate and site the area that a private groundwater well may be established on the property listed above by the Environmental Health Specialists of Granville County. If one does not locate the well in the approved area and complete the well as specified by the 15A NCAC .02C rules, then permits may be revoked. At completion of drilling of the well, grout must be witnessed by EHS and a well log turned into Environmental Health.

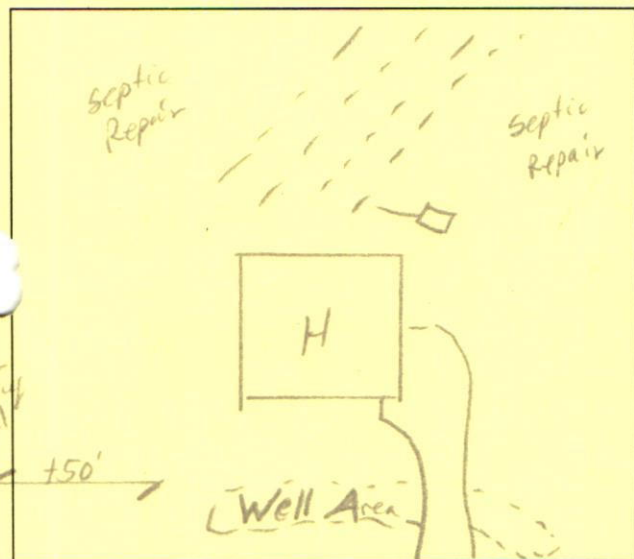
Minimum Setbacks: (these are the main setbacks, but not all required setbacks)

Setback from property lines – 10 ft

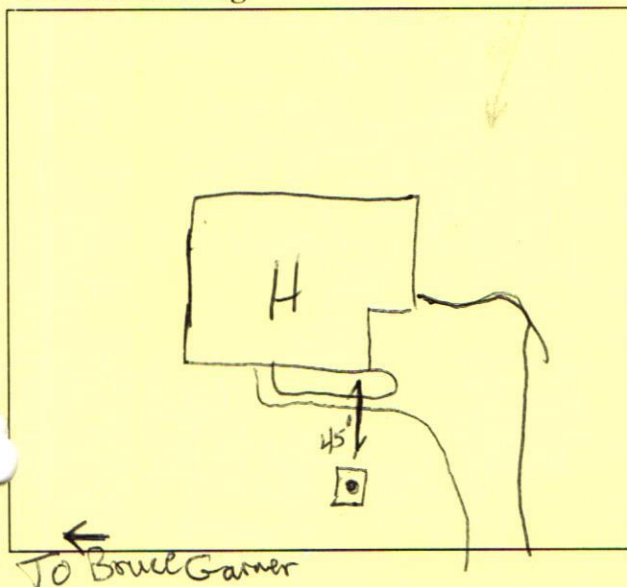
Setback from septic tank and drain field, including repair area – 100 ft

Setback from structural foundations – 25 ft

Setback from ponds, lakes or other bodies of water – 50 ft

Site Sketch:**Conditions:**Call 693-2688
W/ quoting**Authorized Agent:**David Rumblee
7-13-2012**# 1 Well Grout: (Circle or write in)**Witnessed: Yes or No EHS Agent: David RumbleeDate: 12-19-12 Annular Space Open: Yes or NoOver reamed: Yes or No Depth Grouted: 20'Method: Pump ☒ Poured ☐ Pressure ☐

Well Log received: Yes or No (EHS to Attach to Permit)

Driller Name: Southern Well Cert. # Depth: 500' Casing Depth: 76' GPM: 6**As Built Drawing:****# 2 Well Final: (Place a check mark when finalized)**Seal Present and Intact: ☒ Air Vent: ☒Hose Spigot: ☒ Electrical Box: ☒Pump Installer Tag: ☒ Well Installer Tag: ☒All holes sealed: ☒ 12" above grade: ☒**Comments:****# 3 Well Completion Permit:** David Rumblee EHSDate Completed: 2-18-13**# 4 Water Samples Taken: Date:** 2-18-13EHS: DC Results: Retest: Results: * did not want re-tested 3-25-13

PERMIT NUMBER 07284

**GRANVILLE-VANCE DISTRICT HEALTH DEPARTMENT
IMPROVEMENT AND OPERATION PERMITS**

zoning # 17504

COUNTY:	TAX NO.	TYPE OF ESTABLISHMENTS			*THIS PERMIT SHALL BE ACCOMPANIED BY A LAYOUT SHOWN ON A PLAT, INCLUDING SYSTEM REQUIREMENTS.
OWNER:	SR. NO.	RESIDENCE ☒	NUMBER OF BEDROOMS:	NUMBER OF OCCUPANTS:	
		BUSINESS ☐			
		OTHER ☐			
APPLICANT'S ADDRESS:		WATER SUPPLY	WELL ☒	OTHER ☐	*THIS IMPROVEMENT PERMIT IS SUBJECT TO REVOCATION IF THE INTENDED USES CHANGE FROM THOSE SHOWN ON THE IMPROVEMENT PERMIT. CHANGES SHALL REQUIRE HEALTH DEPARTMENT APPROVAL.
		TYPE OF WASTEWATER SYSTEM	INITIAL INSTALLATION	REPAIR (PUMP)	
PROPERTY ADDRESS/LOCATION:		DESIGN FLOW:			
		LTAR:			
SUBDIVISION:		ABSORPTION AREA:			
LOT NUMBER:		TRENCH WIDTH:			
REFERENCE SKETCH (SEE PLAT FOR DETAILS)		TRENCH DEPTH:			
		TRENCH SPACING:			
		TOTAL TRENCH LENGTH:			
		NUMBER OF TRENCHES:			
		GRAVEL DEPTH:			PERMIT VALID FOR: 5 YEARS
		TANK SIZE:			YES ☒ NO ☐
		PUMP TANK SIZE:			NO EXPIRATION
		DISTRIBUTION DEVICE:			

Set tank as shown to allow for equal length drain lines
a step-down may be needed on last line

IMPROVEMENT PERMIT DATE: 7-13-2012/1-18-12
FOR: Savvy Homes
ISSUED BY: David Cumber

CONSTRUCTION AUTHORIZATION FOR IMPROVEMENT PERMIT# 7284

Unless otherwise indicated, the same conditions above apply regarding system type, layout, location and installation requirements.
(The wastewater system cannot be installed until authorization is signed)

Comments: Contours flagged in field, orange top & orange bottom (100')

Date: 7-13-2012 Environmental Health Specialist: David Cumber
Construction Authorization Addendum ☐ Yes ☒ No

OPERATION PERMIT DATE: 1-8-13
SYSTEM INSTALLED BY: Blackley Brothers
ISSUED BY: David Cumber
PERFORMANCE, MONITORING, MAINTENANCE AND OPERATION
AS REQUIRED BY RULE .1961