

36
120
12

SEWAGE DISPOSAL SYSTEM INSTALLATION REVIEW

SEPTIC AND PUMP TANK INSPECTION

SEPTIC TANK

Manufacturer Ellis
Date of Manufacture 6-10-16
Stamp ✓
Capacity 1000
Tee _____
Baffle _____
Sealant _____
AIR GAP _____, FILTER _____, RISER _____

INITIAL

WV

DATE

10/24/2016

PUMP TANK

Manufacture _____
Date of Manufacture _____
Stamp _____
Capacity _____
Sealant _____
Manhole _____
RISER _____, SEALANT _____

MECHANICAL INSPECTION

PUMP

Manufacturer and Model # _____
Control Panel _____
Alarm _____
Electrical Connection _____
SEALANT AROUND CONDUIT _____

NITRIFICATION/DISTRIBUTION AND DRAINFIELD INSPECTION

DISTRIBUTION BOX

Level ✓
Equal Distribution ✓
Other _____

DISTRIBUTION MANIFOLD

Pipe Size _____
Gate Valves _____
Other _____

OTHER DISTRIBUTION

Type _____

NITRIFICATION LINES

Trench Width
Trench Length
Trench Grade
Stone Depth

LINE 1

3
120
✓
18"
30 panels

LINE 2

3
120
✓
18"
30 panels

LINE 3

3
120
✓
18"
30 panels

LINE 4

3
120
✓
18"
30 panels

LINE 5

LINE 6

WELL INSPECTION

LOCATION OF WELL

COMMENTS:

Granville - Vance District Health Department
Environmental Health

Final Sketch

Pin _____

____ Improvement Permit

 Construction Authorization

Jerry Dickerson
Applicant's Name

Permit No. 8791


NA
Subdivision - Section - Lot

Physical Address: 9590 Amis Chapel Rd

CBS Lin Co, Inc
System Installer

10/26/2016
Date

System design and details as installed.

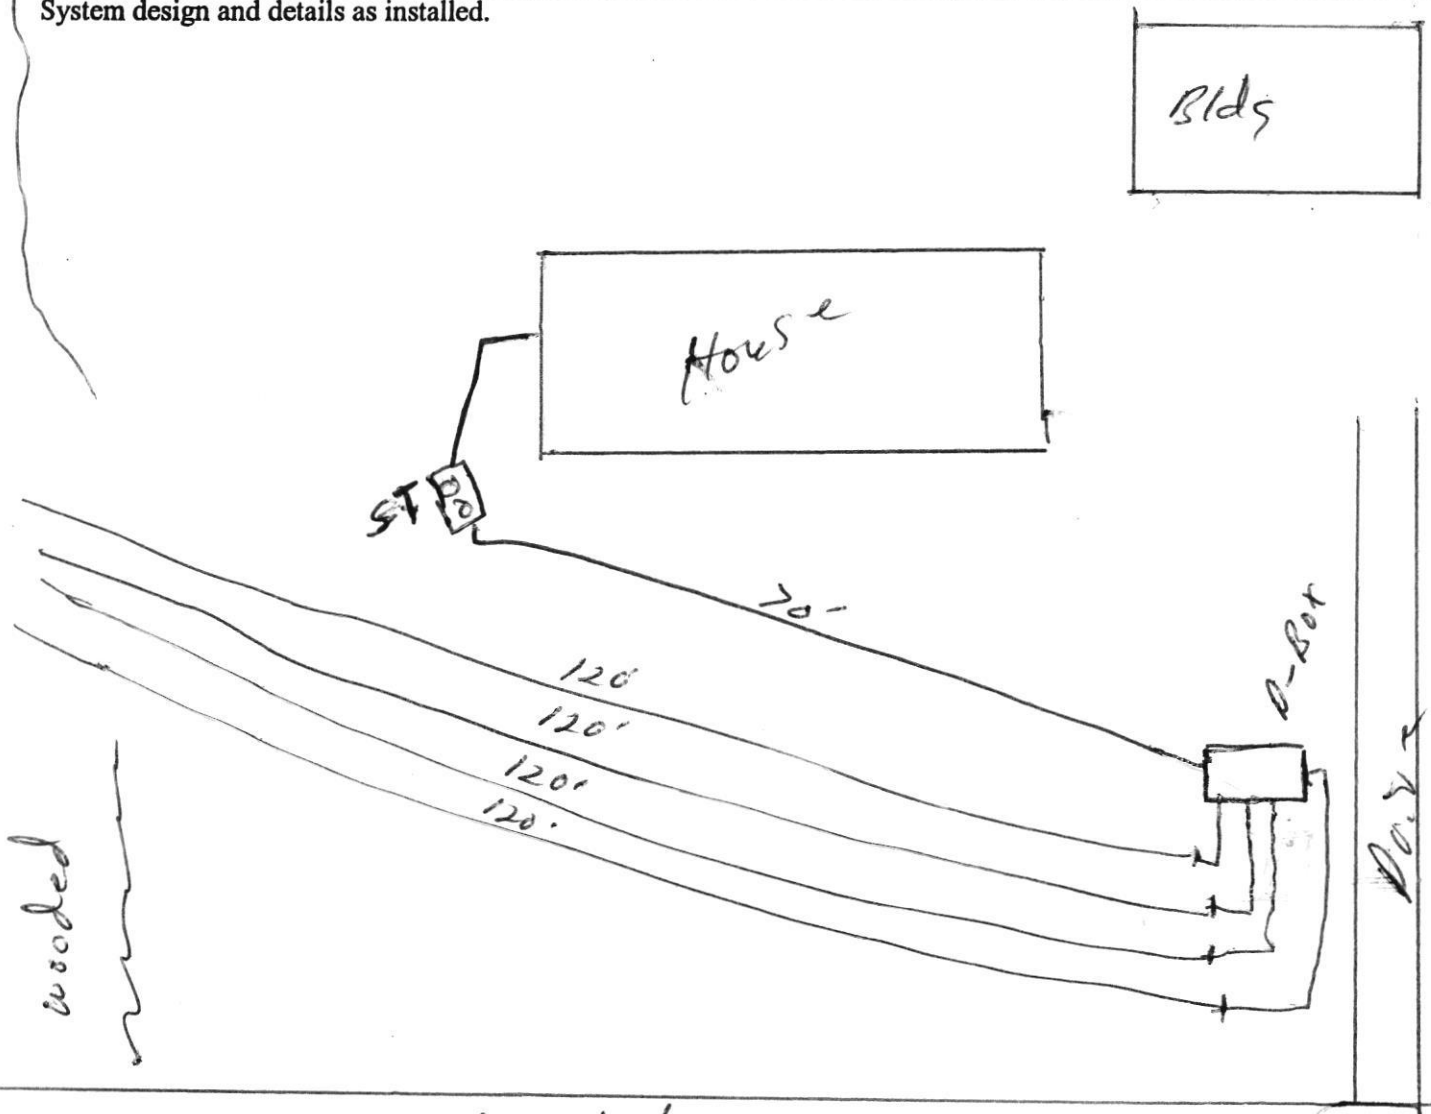

Amis Chapel Rd

Walter D. Vey
Authorized Signature

10/26/2016
Date

GRANVILLE-VANCE DISTRICT HEALTH DEPARTMENT IMPROVEMENT AND OPERATION PERMITS

COUNTY:	TAX NO.	TYPE OF ESTABLISHMENTS			*THIS PERMIT SHALL BE ACCOMPANIED BY A LAYOUT SHOWN ON A PLAT, INCLUDING SYSTEM REQUIREMENTS.
APPLICANT:	SR. NO. <u>1403</u>	RESIDENCE ☐	NUMBER OF BEDROOMS:	NUMBER OF OCCUPANTS:	
	APPLICANT'S NAME & ADDRESS:	BUSINESS ☐	WELL ☐	PUBLIC ☐	
		OTHER ☐			
		WATER SUPPLY	OTHER ☐		*THIS IMPROVEMENT PERMIT IS SUBJECT TO REVOCATION IF THE INTENDED USES CHANGE FROM THOSE SHOWN ON THE IMPROVEMENT PERMIT. CHANGES SHALL REQUIRE HEALTH DEPARTMENT APPROVAL.
		TYPE OF WASTEWATER SYSTEM	INITIAL INSTALLATION	REPAIR	
PROPERTY ADDRESS/LOCATION:		DESIGN FLOW:		<u>360</u>	
SUBDIVISION:		LTAR:		<u>0.25</u>	
LOT NUMBER:		ABSORPTION AREA:		<u>1440</u>	
REFERENCE SKETCH (SEE PLAT FOR DETAILS) <u>cover with suitable soil only</u>		TRENCH WIDTH:		<u>3'</u>	
		TRENCH DEPTH:		<u>36"</u>	
		TRENCH SPACING:		<u>9'</u>	
		TOTAL TRENCH LENGTH:	<u>7590</u>	<u>480'</u>	
		NUMBER OF TRENCHES:		<u>4</u>	
		GRAVEL DEPTH:		<u>18" gravel</u>	
		TANK SIZE:		<u>1000</u>	
		PUMP TANK SIZE:		<u>NA</u>	
		DISTRIBUTION DEVICE:		<u>D-Box</u>	PERMIT VALID FOR: 5 YEARS YES ☐ NO ☐

IMPROVEMENT PERMIT DATE: 9/22/2016*****

FOR:

 ISSUED BY: Walter T. Doyle REHS

CONSTRUCTION AUTHORIZATION FOR IMPROVEMENT PERMIT# 8791

Unless otherwise indicated, the same conditions above apply regarding system type, layout, location and installation requirements.
(The wastewater system cannot be installed until authorization is signed)

Comments:

Date: 9/22/2016 Environmental Health Specialist: Walter T. Doyle REHS
Construction Authorization Addendum ☐ Yes ☐ No

OPERATION PERMIT

 DATE: 10/26/2016

 SYSTEM INSTALLED BY: CLS

 ISSUED BY: Walter T. Doyle

**PERFORMANCE, MONITORING, MAINTENANCE AND OPERATION
AS REQUIRED BY RULE .1961**