

## Granville - Vance District Health Department

00960

## Environmental Health

## Well Construction Permit

Owner/Applicant: NBC HomesDate: 12-27-12Address or Location of Property: Riverstone Dr.Subdivision & Lot #: J. Conwood 7Septic Permit #: 7359Zoning Permit #: 17655Environmental Health Specialist: David Cumber

This well permit is to locate and site the area that a private groundwater well may be established on the property listed above by the Environmental Health Specialists of Granville County. If one does not locate the well in the approved area and complete the well as specified by the 15A NCAC .02C rules, then permits may be revoked. At completion of drilling of the well, grout must be witnessed by EHS and a well log turned into Environmental Health.

Minimum Setbacks: (these are the main setbacks, but not all required setbacks)


Setback from property lines - 10 ft

Setback from septic tank and drain field, including repair area - 100 ft

Setback from structural foundations - 25 ft

Setback from ponds, lakes or other bodies of water - 50 ft


Site Sketch:

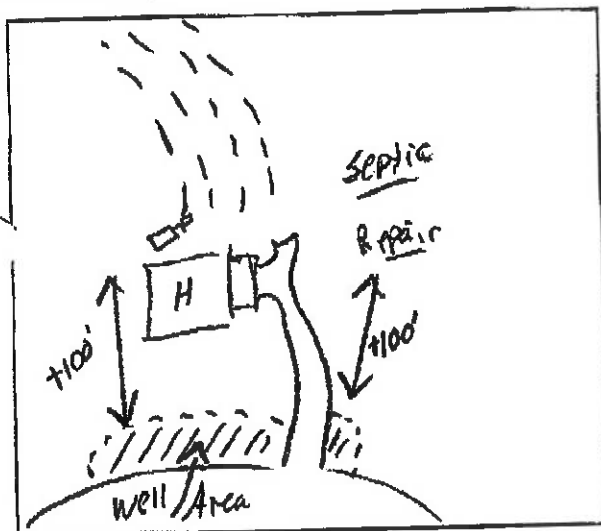Conditions: Call 693-2688  
w/ questionsAuthorized Agent: David CumberDate: 12-27-12

# 1 Well Grout: (Circle or write in)

Witnessed: Yes or No EHS Agent: David CumberDate: 4-24-13 Annular Space Open: Yes or NoOver reamed: Yes or No Depth Grouted: 20Method: Pump X Poured PressureWell Log received: Yes or No (EHS to Attach to Permit)Driller Name: Southern Cert. # Depth: 400' Casing Depth:  GPM: 6portland cement

As Built Drawing:

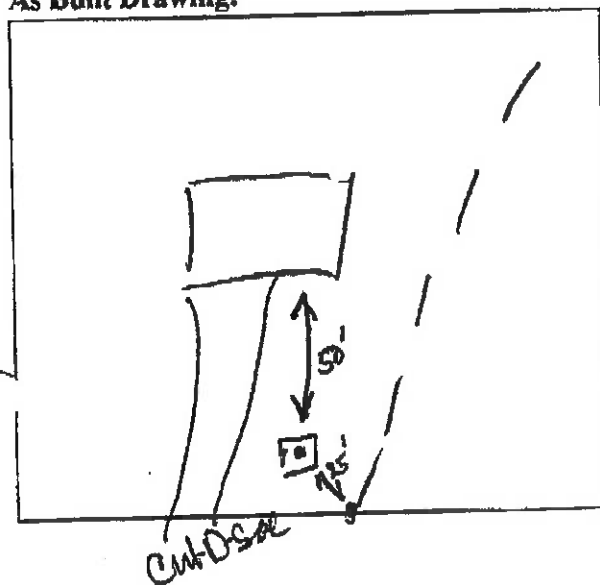

# 2 Well Final: (Place a check mark when finalized)

Seal Present and Intact: C Air Vent: Hose Spigot:  Electrical Box: Pump Installer Tag: C Well Installer Tag: All holes sealed:  12" above grade: Comments: 3/4 HP Pump  
260' depth# 3 Well Completion Permit: David Cumber EHSDate Completed: 6/25/13# 4 Water Samples Taken: Date: 6/25/13EHS: DC Results: Retest:  Results:

Granville County Health Department  
Environmental Health

782500988559

Permit Number 7359

☒ Improvement Permit

☒ Construction Authorization


Site Sketch

MBC Homes  
Applicants Name  
Daniel Carter  
Authorized State Agent

Ironwood Pt. A 7  
Subdivision - Section - Lot  
12-27-12  
Date

System components represent approximate contours only. The contractor must flag the system prior to beginning the installation to insure that proper grade is maintained.

Scale: 1"=50'  
Approx.

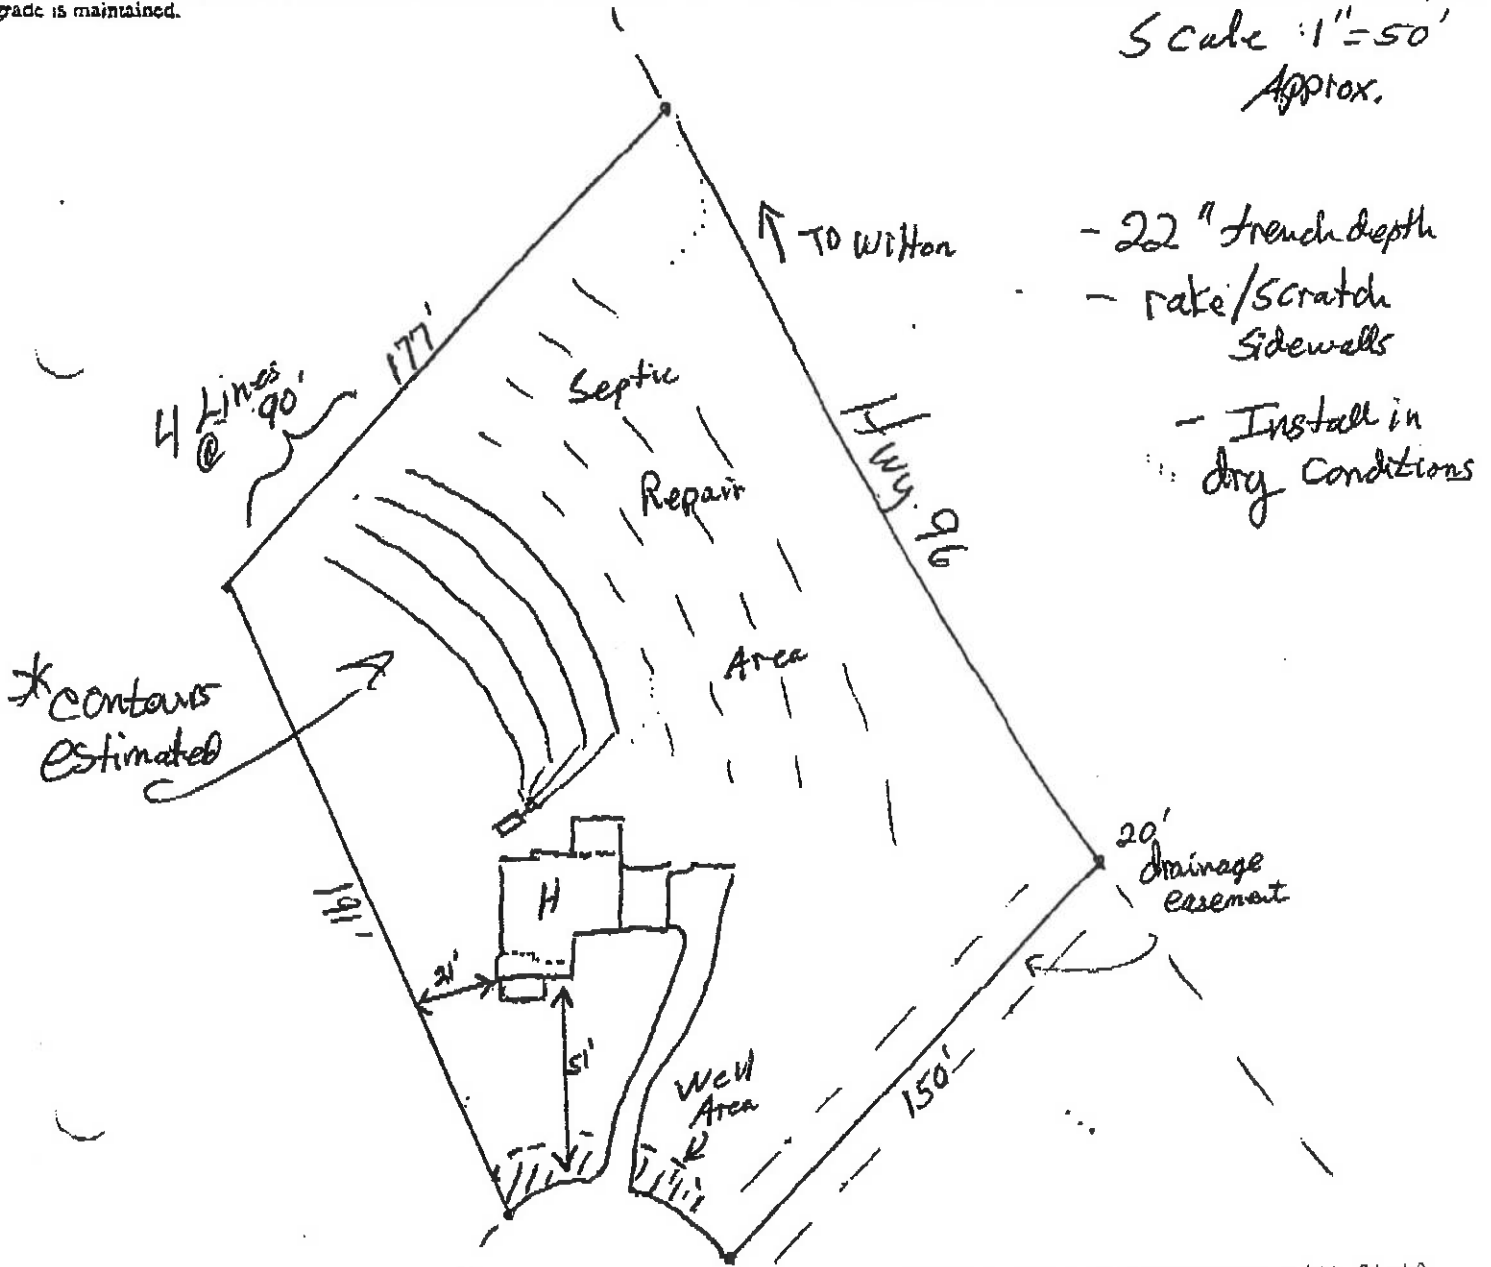

- 22" trench depth

- rake/scratch  
sidewalls

- Install in  
dry conditions