


NOTE: Make sketch of installation showing location of house, septic tanks, privies, water supplies on adjacent property, etc. Write in measurements in order that installations may be located at later date.

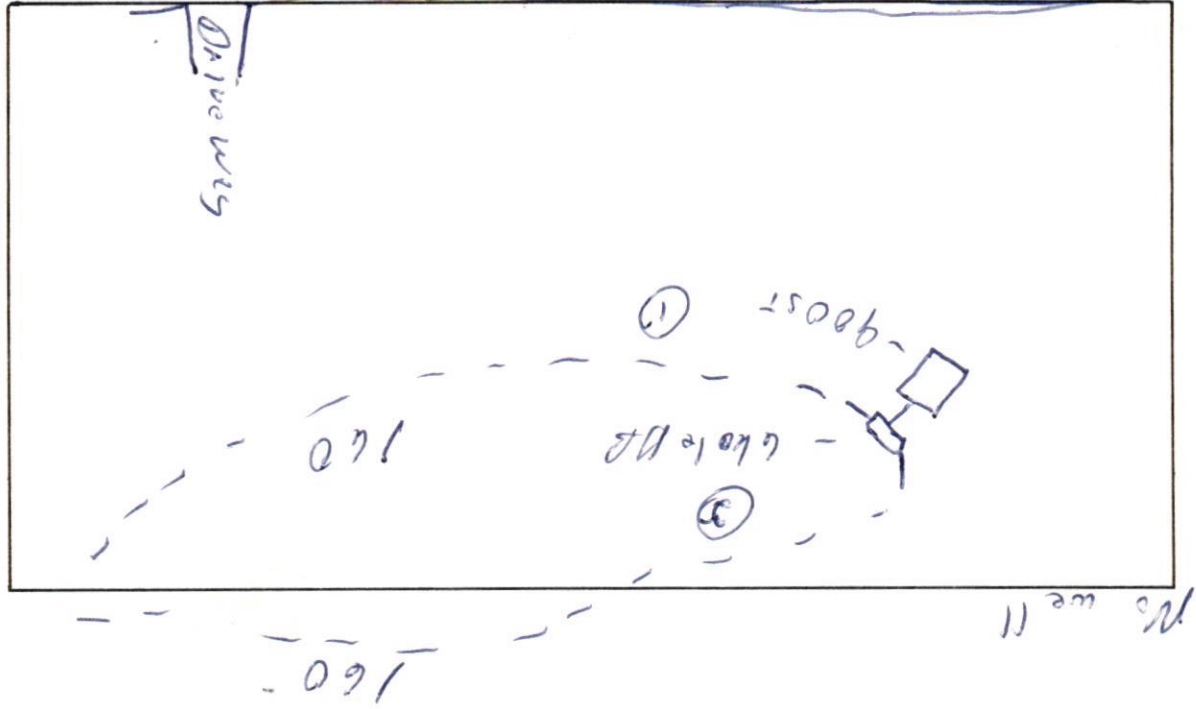

0277 GRANVILLE-VANCE HEALTH DEPARTMENT—Sewage Disposal Record

0237 Owner or Contractor Donald S. Humphries Date 2-13-87 S.R. No. 1514

Location/Address Route #5 Oxford N.C.

Subdivision/Mobile Home Park Name Poplar Creek Farm Lot Size 1.74 acre
Lot No. 31

New System ☒ Repair ☐

House ☐ Mobile Home ☒ Business ☐

No. Bedrooms 3 No. People 5 No. Toilets 2

Water Supply: Private ☒ Approved ☐

Semi-Public ☐ Unapproved ☐

Public ☐ None ☐

Nitrification System:

Tank Size 900 gal.

Distribution Box yes No. Lines 2

Nitrification Field 320 - 460 Sq. Ft.

Lines:	1	2	3	4	5	6
Width	<u>36"</u>	<u>26"</u>				
Length	<u>160"</u>	<u>160"</u>				
Grade	<u>2"</u>	<u>10"</u>				
Stone Depth	<u>12"</u>	<u>12"</u>				

Layout to be followed by installer:

Improvements Permit By James C. Barrett Installer W. Hight

Certificate of Completion By Bolby E. Greene Date of Inspection March 24, 1987

* Construction must comply with all other applicable state and local regulations, but the permit is not a guarantee that the system will not malfunction and the Granville-Vance Health District will not be held responsible for a malfunctioning system.