

NO. 1476 SEWAGE DISPOSAL RECORD — GRANVILLE COUNTY

Owner ☒ L. D. Franklin

RPD-Street Rt. 1, Stea

Tenant ☐ Newton

SR No. _____

Subdivision Name _____

Lot No. _____ Section or Block No. _____

New System ☒ Repairs ☐ Privy ☐

Nitrification System:

House ☒ Trailer ☐ Business ☐

Tank Size 900 Gal.

No. Bedrooms 3 Garbage Disposal ☐ Yes ☐ No ☐

Distribution Box Yes

No. Bathrooms 1 Auto. Dishwasher ☐ ☐

Nitrification Field 960 Sq. Ft.

No. in Family 5 Auto. Washing Machine ☐ ☐

Nitrification Lines 320 Length

Nitrification Line 76" Width

Water Supply: Individual ☒ Public ☐

No. Nitrification Lines 3

Lot Area Farm

Stone Depth 12"

*Remarks _____

Grade Boards Yes ☒ No ☐

Improvements Permit By Sam E. Wheeler

Date 12-11-70


Certificate of Completion By Sam E. Wheeler

Date 12-12-70

Installed By Ellington

OVER →

NOTE: Make sketch of installation showing location of house, septic tanks, privies, water supplies on adjacent property, etc. Write in measurements in order that installations may be located at later date.

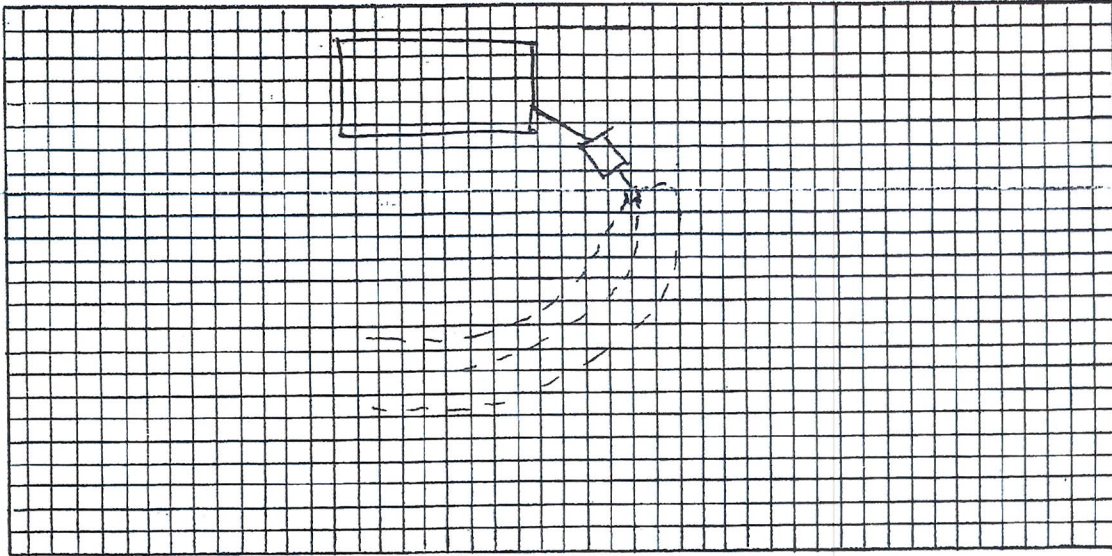

FRONT