

20 # 20361

PERMIT NUMBER 1136

GRANVILLE-VANCE DISTRICT HEALTH DEPARTMENT
IMPROVEMENT AND OPERATION PERMITS

COUNTY: Granville	TAX NO.	TYPE OF ESTABLISHMENTS			*THIS PERMIT SHALL BE ACCOMPANIED BY A LAYOUT SHOWN ON A PLAT, INCLUDING SYSTEM REQUIREMENTS.
APPLICANT'S NAME & ADDRESS Wynn Construction	LOT SIZE	RESIDENCE ☒ BUSINESS ☐ OTHER ☐	NUMBER OF BEDROOMS: 4	NUMBER OF OCCUPANTS: 8 MAX	
		WATER SUPPLY WELL ☐ PUBLIC ☐	INITIAL INSTALLATION	REPAIR	
		TYPE OF WASTEWATER SYSTEM			
PROPERTY ADDRESS/LOCATION: 1321 Sourwood Dr		DESIGN FLOW:	IIIg 480 gpd	IIIg	*THIS IMPROVEMENT PERMIT IS SUBJECT TO REVOCATION IF THE INTENDED USE CHANGES FROM THOSE SHOWN ON THE IMPROVEMENT PERMIT. CHANGES SHALL REQUIRE HEALTH DEPARTMENT APPROVAL.
		LTAR:	3 gpd/ft²		
SUBDIVISION: New Forest IV		ABSORPTION AREA:	1,200 ft²		
LOT NUMBER: 102		TRENCH WIDTH	36"		
REFERENCE SKETCH (SEE PLAT FOR DETAILS)		TRENCH DEPTH:	20-22"		
		TRENCH SPACING:	9' o.c.		PERMIT VALID FOR: 5 YEARS ☒ YES ☐ NO
		TOTAL TRENCH LENGTH:	400'		
		NUMBER OF TRENCHES:	3		
		GRAVEL / ACCEPTED:	Accepted		
		TANK SIZE:	1000 gal		
		PUMP TANK SIZE:	N/A		NO EXPIRATION ☐ YES ☒ NO
		DISTRIBUTION DEVICE:	D-Box		

* Risers on tank
* Call HD for any changes made differing from permit.
* stay 10' off house with top line.

IMPROVEMENT PERMIT

DATE: **7-2-18**

FOR: **Wynn Construction**

ISSUED BY: **Adam Crown**

CONSTRUCTION AUTHORIZATION FOR IMPROVEMENT PERMIT#

1136

Unless otherwise indicated, the same conditions above apply regarding system type, layout, location and installation requirement.

(The wastewater system cannot be installed until authorization is signed)

Comments:

Date: **7-2-18** Environmental Health Specialist:

Construction Authorization Addendum ☐ Yes ☐ No

OPERATION PERMIT

DATE: **9-25-18 (tank & lines) 1-25-19**

SYSTEM INSTALLED BY: **Blackley**

ISSUED BY: **Adam Crown**

PERFORMANCE, MONITORING, MAINTENANCE AND OPERATION

AS REQUIRED BY R.U.F. 1961

Granville-Vance District Health Department

Environmental Health

Final Sketch

Date 9/25/18

N _____

LG homes

1136

Newforest IV 102

Applicant's Name

Permit No.

Subdivision/Lot Number ..

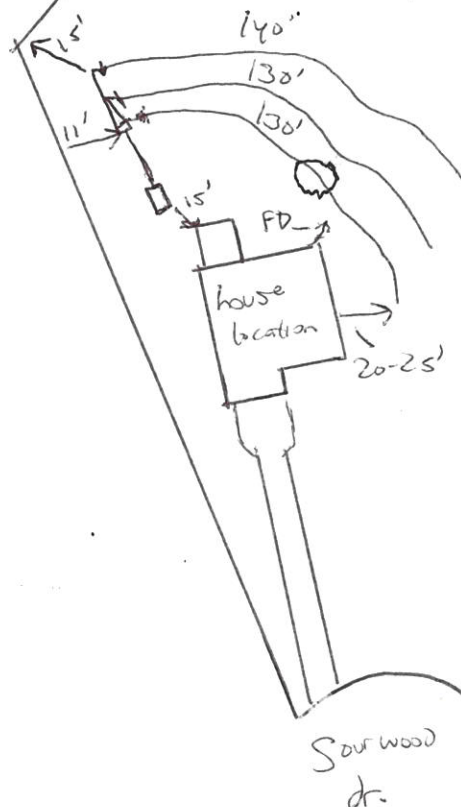
Physical Address: 1321 Sourwood dr.

Blackley

System Installer

[Signature]

Authorized Signature



Granville - Vance District Health Department

Environmental Health

Well Construction Permit

2577

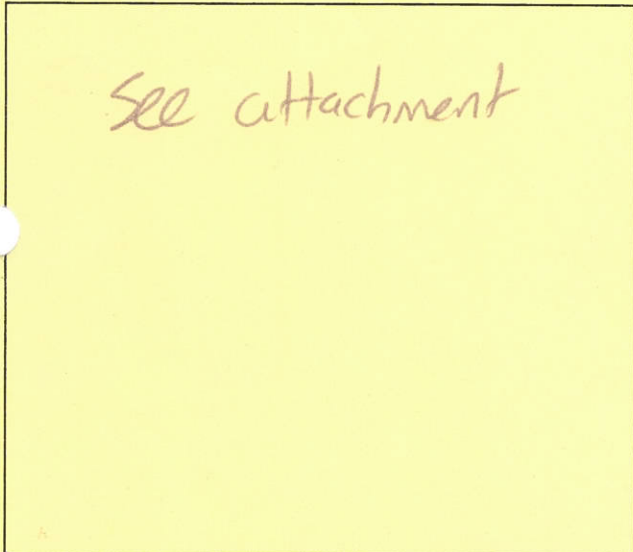
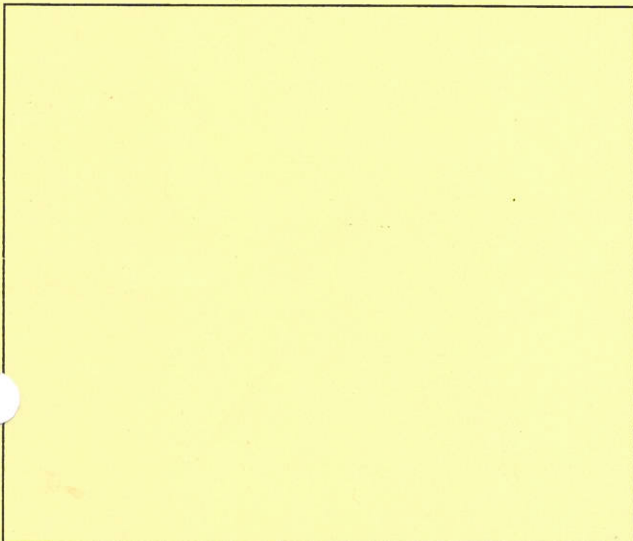
Owner/Applicant: Wynn Construction Date: 7-2-18
Address or Location of Property: 1321 Sourwood Dr

Subdivision & Lot #: New Forest IV / 107 Septic Permit #: 1136
Zoning Permit #: 20361 Environmental Health Specialist: AWC

This well permit is to locate and site the area that a private groundwater well may be established on the property listed above by the Environmental Health Specialists of Granville County. If one does not locate the well in the approved area and complete the well as specified by the 15A NCAC .02C rules, then permits may be revoked. At completion of drilling of the well, grout must be witnessed by EHS and a well log turned into Environmental Health.

Minimum Setbacks: (these are the main setbacks, but not all required setbacks)

Setback from property lines – 10 ft Setback from septic tank and drain field, including repair area – 100 ft
Setback from structural foundations – 25 ft Setback from ponds, lakes or other bodies of water – 50 ft

Site Sketch:**Conditions:**Authorized Agent: Adam CorbinDate: 7-2-18**# 1 Well Grout: (Circle or write in)**Witnessed: Yes or No EHS Agent: Adam CorbinDate: 10-29-18 Annular Space Open: Yes or NoOver reamed: Yes or No Depth Grouted: 204Method: Pump ☒ Poured ☐ PressureWell Log received: Yes or No (EHS to Attach to Permit)Driller Name: Southern Cert. # _____Depth: 400 Casing Depth: 62 GPM: 20**As Built Drawing:****# 2 Well Final: (Place a check mark when finalized)**Seal Present and Intact: ☒ Air Vent: ☒Hose Spigot: ☒ Electrical Box: ☒Pump Installer Tag: ☒ Well Installer Tag: ☒All holes sealed: ☒ 12" above grade: ☒**Comments:** _____**# 3 Well Completion Permit:** Adam Corbin EHSDate Completed: 1-4-19**# 4 Water Samples Taken: Date:** _____

EHS: _____ Results: _____

Retest: _____ Results: _____