


NOTE: Make sketch of installation showing location of house, septic tanks, privies, water supplies on adjacent property, etc. Write in measurements in order that installations may be located at later date.

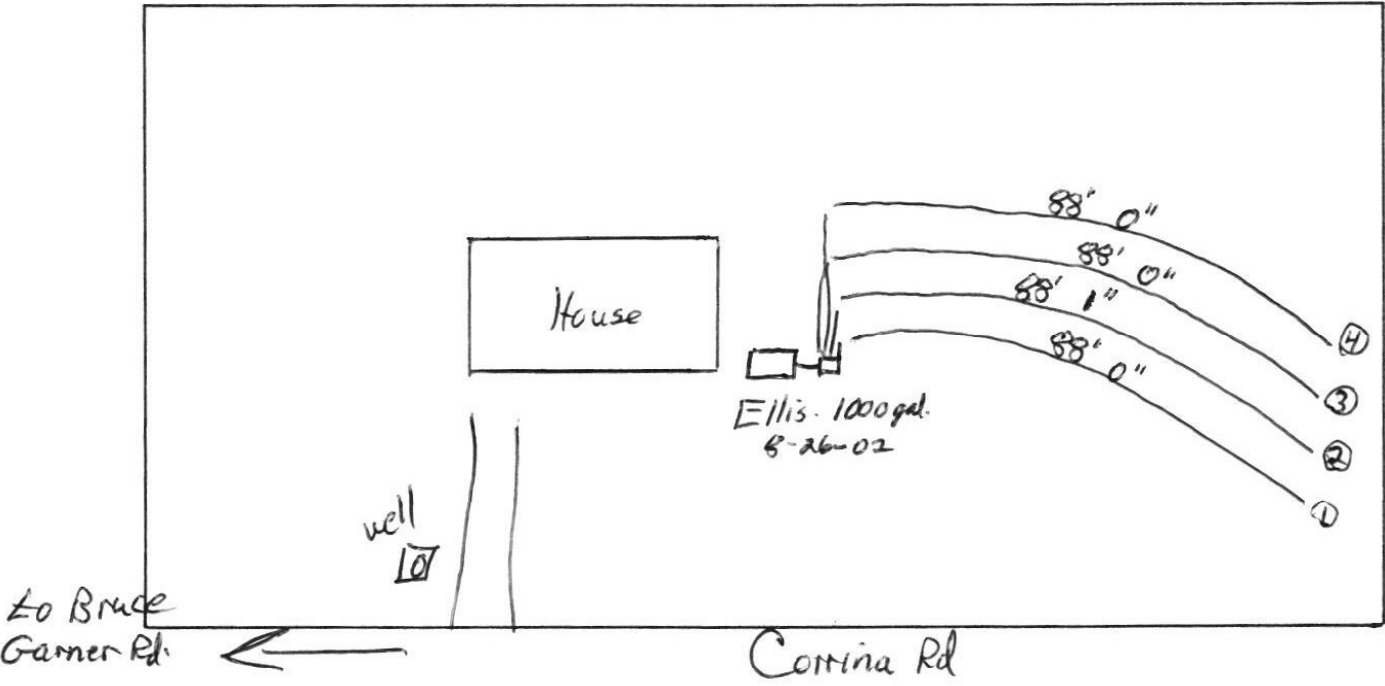

GRANVILLE-VANCE HEALTH DEPARTMENT—Sewage Disposal Record

Owner or Contractor Graham Sherron / Cardinal Road Date 5-8-02 S.R. No. 1711
 Location/Address Corrine Rd (off Bruce Garner Rd.)
 Subdivision/Mobile Home Park Name Wilson Place Lot Size ± 1.47 AC
 Permit No. # _____ Lot No. 25

New System ☒ Repair _____
 House ☒ Mobile Home _____ Business _____
 No. Bedrooms 3 No. People _____ No. Toilets _____
 Water Supply: Private ☒ Approved _____
 Semi-Public _____ Unapproved _____
 Public _____ None _____

Nitrification System:


Tank Size 1000 gal.
 Distribution Box 4 No. Lines 4
 Nitrification Field 1050 Sq. Ft.
 Lines: 1 2 3 4 5 6
 Width 3' 3' 3' 3' ____ ____
 Length 88' 88' 88' 88' ____ ____
 Grade 0" 1" 0" 0" ____ ____
 Stone Depth 12" 12" 12" 12" ____ ____

Layout to be followed by installer:

** Sketch on back*

Improvements Permit By M.E. Yount Installer Cole's Backhoe Service
 Certificate of Completion By David Cumbre Date of Inspection 11-26-02


* Construction must comply with all other applicable state and local regulations, but the permit is not a guarantee that the system will not malfunction and the Granville-Vance Health District will not be held responsible for a malfunctioning system.

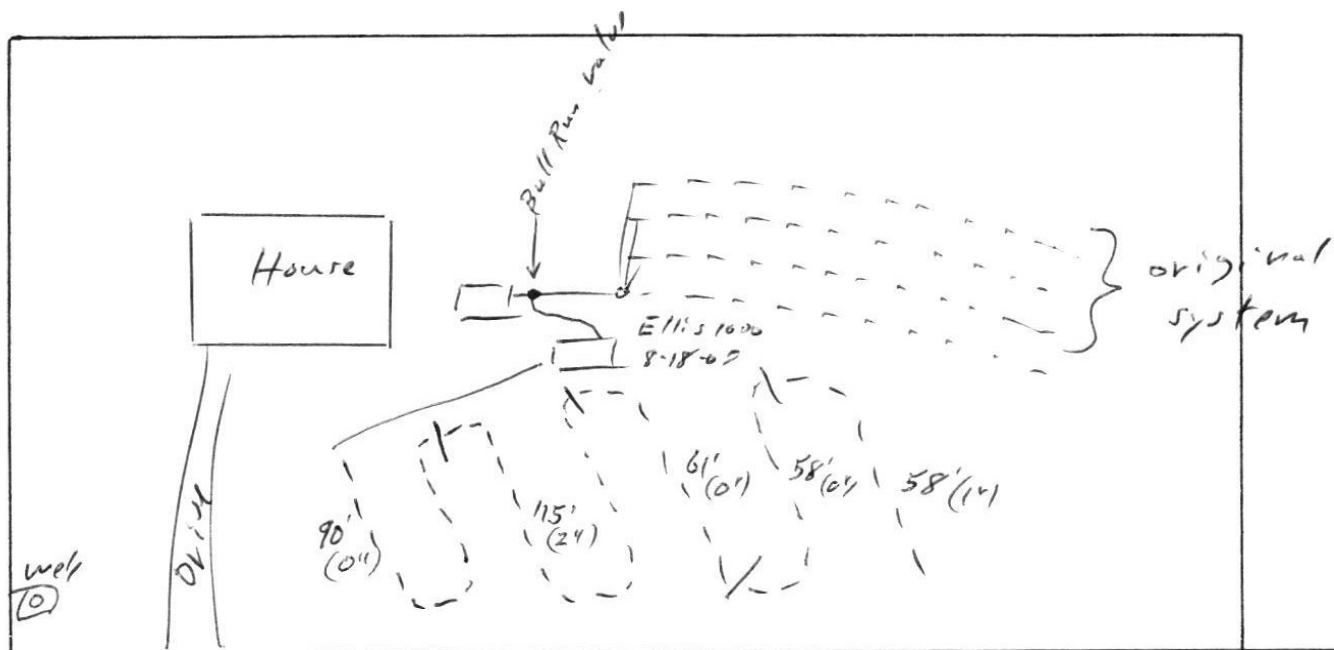

Corrina Road

NOTE: Make sketch of installation showing location of house, septic tanks, privies, water supplies on adjacent property, etc. Write in measurements in order that installations may be located at later date.

Bruce Garner Rd SR. 1711

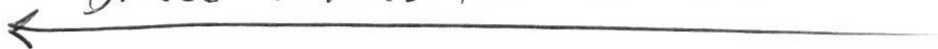

GRANVILLE-VANCE HEALTH DEPARTMENT—Sewage Disposal Record

Owner or Contractor David Blair Date 9-29-05 S.R. No. 1711
 Location/Address 1119 Corkina Road off Bruce Garner Rd.
 Subdivision/Mobile Home Park Name Wilson Place Lot Size _____
 Permit No. # 3958 Lot No. 25

New System _____ Repair ☒
 House ☒ Mobile Home _____ Business _____
 No. Bedrooms 3 No. People 3 No. Toilets _____
 Water Supply: Private ☒ Approved _____
 Semi-Public _____ Unapproved _____
 Public _____ None _____

Layout to be followed by installer:

Nitrification System: septic pump tank
 Tank Size existing gal. 1000 gal.
 Distribution Box _____ No. Lines _____
 Nitrification Field 1200 Sq. Ft.
 Lines: 1 2 3 4 5 6
 Width 3' 3' 3' 3' 3' _____
 Length 90' 115' 61' 58' 58' _____
 Grade 0' 2' 0' 0' 1' _____
 Stone Depth 12" 12" 12" 12" 12" _____
Serial Distribution

Improvements Permit By Eddie Yount Installer Colo. Backhoe Service
 Certificate of Completion By Eddie Yount Date of Inspection 9-29-05 9-30-05

* Construction must comply with all other applicable state and local regulations, but the permit is not a guarantee that the system will not malfunction and the Granville-Vance Health District will not be held responsible for a malfunctioning system.