

9-30 Blockley

PERMIT NUMBER 8750

GRANVILLE-VANCE DISTRICT HEALTH DEPARTMENT IMPROVEMENT AND OPERATION PERMITS

COUNTY:	TAX NO.	TYPE OF ESTABLISHMENTS			*THIS PERMIT SHALL BE ACCOMPANIED BY A LAYOUT SHOWN ON A PLAT, INCLUDING SYSTEM REQUIREMENTS.
GRANVILLE	SR. NO.	RESIDENCE ☒	NUMBER OF BEDROOMS: <u>4</u>	NUMBER OF OCCUPANTS: <u>8 max</u>	
		BUSINESS ☐			
APPLICANT: <u>WYNN CONST.</u>		OTHER ☐			*THIS IMPROVEMENT PERMIT IS SUBJECT TO REVOCATION IF THE INTENDED USES CHANGE FROM THOSE SHOWN ON THE IMPROVEMENT PERMIT. CHANGES SHALL REQUIRE HEALTH DEPARTMENT APPROVAL.
APPLICANT'S NAME & ADDRESS: <u>2550 CAPITAL DRIVE</u> <u>CRESSKOPF, NC 27522</u>		WATER SUPPLY <u>PRIVATE</u>	WELL ☒	OTHER ☐	
PROPERTY ADDRESS/LOCATION: <u>BUTTERFLY CIRCLE</u>		TYPE OF WASTEWATER SYSTEM	INITIAL INSTALLATION	REPAIR	
SUBDIVISION: <u>CHESLEEIGH</u>		DESIGN FLOW:	<u>480 GPD</u>	<u>SAME</u>	
LOT NUMBER: <u>127</u>		LTAR:	<u>0.3 GPD/FT²</u>		
REFERENCE SKETCH (SEE PLAT FOR DETAILS) <u>* STAY 10' OFF PROPERTY LINE WITH TANKS & DRAINAGES</u> <u>* STAY 5' OFF WITH SUPPLY LINE</u> <u>* 5' OFF HOUSE PERMIT W/ DRAINFIELD</u>		ABSORPTION AREA:	<u>1,600 FT²</u>		
		TRENCH WIDTH:	<u>3'</u>		
		TRENCH DEPTH:	<u>19"</u>		
		TRENCH SPACING:	<u>9' O.C.</u>		
		TOTAL TRENCH LENGTH:	<u>400' ACCEPTED</u>		
		NUMBER OF TRENCHES:	<u>4</u>		
		GRAVEL DEPTH:	<u>ACCEPTED</u>		PERMIT VALID FOR: 5 YEARS ☒ YES ☐ NO
		TANK SIZE:	<u>1000 GALLON</u>		
		PUMP TANK SIZE:	<u>1000 GALLON</u>		NO EXPIRATION YES ☐ NO ☒
		DISTRIBUTION DEVICE:	<u>MANHOLE</u>		

IMPROVEMENT PERMIT DATE: 8/17/16

FOR: WYNN CONST.
ISSUED BY: [Signature]

CONSTRUCTION AUTHORIZATION FOR IMPROVEMENT PERMIT# 8750

Unless otherwise indicated, the same conditions above apply regarding system type, layout, location and installation requirements.
(The wastewater system cannot be installed until authorization is signed)

Comments: CONTRACTOR MUST ESTABLISH & FOLLOW CONVEYANCE

Date: 8/17/16 Environmental Health Specialist: [Signature] Construction Authorization Addendum ☐ Yes ☒ No

OPERATION PERMIT

DATE: 11/14/16

SYSTEM INSTALLED BY: [Signature]
ISSUED BY: [Signature]

PERFORMANCE, MONITORING, MAINTENANCE AND OPERATION
AS REQUIRED BY RULE .1961

Granville - Vance District Health Department

Environmental Health Well Construction Permit

1917

Owner/Applicant: WYNN CONSTRUCTION

Date: 8/17/16

Address or Location of Property: BUTTERFLY CIRCLE

Subdivision & Lot #: CHESLICK #127

Septic Permit #: 8750

Zoning Permit #: 19457

Environmental Health Specialist: T. Bell


This well permit is to locate and site the area that a private groundwater well may be established on the property listed above by the Environmental Health Specialists of Granville County. If one does not locate the well in the approved area and complete the well as specified by the 15A NCAC .02C rules, then permits may be revoked. At completion of drilling of the well, grout must be witnessed by EHS and a well log turned into Environmental Health.

Minimum Setbacks: (these are the main setbacks, but not all required setbacks)

Setback from property lines - 10 ft Setback from septic tank and drain field, including repair area - 100 ft

Setback from structural foundations - 25 ft Setback from ponds, lakes or other bodies of water - 50 ft

Site Sketch:

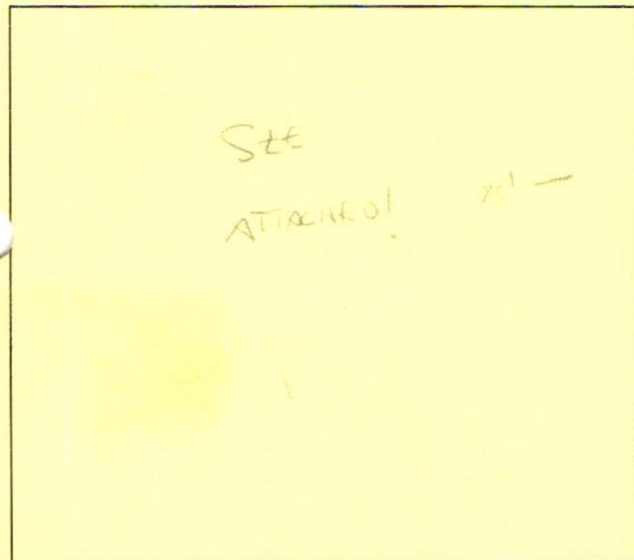

Conditions: MAINTAIN SETBACKS

Authorized Agent: T. Bell

Date: 8/17/16

1 Well Grout: (Circle or write in)

Witnessed: Yes or No EHS Agent: Adam Curren

Date: 1-18-17 Annular Space Open: Yes or No

Over reamed: Yes or No Depth Grouted: 20ft


Method: Pump ✓ Poured Pressure

Well Log received: Yes or No (EHS to Attach to Permit)

Driller Name: Southern Cert. #

Depth: 360' Casing Depth: 82 GPM: 5

As Built Drawing:

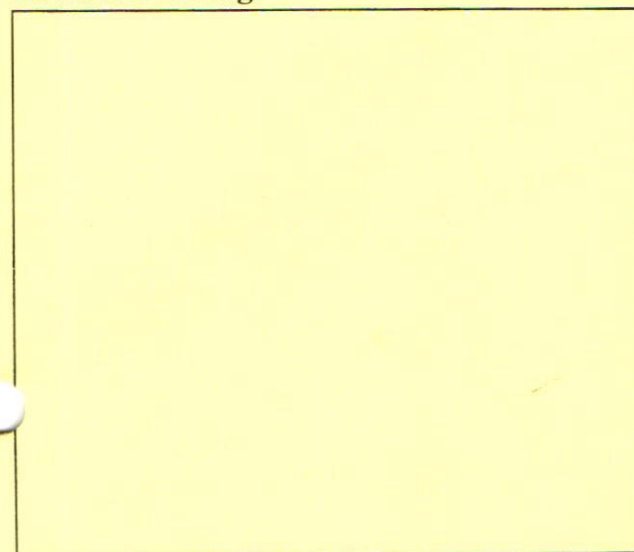

2 Well Final: (Place a check mark when finalized)

Seal Present and Intact: ✓ Air Vent: ✓

Hose Spigot: ✓ Electrical Box: ✓

Pump Installer Tag: ✓ Well Installer Tag: ✓

All holes sealed: ✓ 12" above grade: ✓

Comments:

3 Well Completion Permit: T. Bell EHS

Date Completed: 2-6-17

4 Water Samples Taken: Date:

EHS: Results:

Retest: Results:

SEWAGE DISPOSAL SYSTEM INSTALLATION REVIEW

SEPTIC AND PUMP TANK INSPECTION

SEPTIC TANK	INITIAL	DATE
Manufacturer <u>Elks</u>	_____	_____
Date of Manufacture <u>8/29/16</u>	_____	_____
Stamp <u>57B 789</u>	_____	_____
Capacity <u>1000</u>	_____	_____
Tee <u>✓</u>	_____	_____
Baffle <u>✓</u>	_____	_____
Sealant <u>✓</u>	_____	_____
AIR GAP <u>✓</u> , FILTER <u>✓</u> , RISER _____	_____	_____

PUMP TANK		
Manufacture _____	_____	_____
Date of Manufacture _____	_____	_____
Stamp _____	_____	_____
Capacity _____	_____	_____
Sealant _____	_____	_____
Manhole _____	_____	_____
RISER _____, SEALANT _____	_____	_____

MECHANICAL INSPECTION

PUMP		
Manufacturer and Model # _____	_____	_____
Control Panel _____	_____	_____
Alarm _____	_____	_____
Electrical Connection _____	_____	_____
SEALANT AROUND CONDUIT _____	_____	_____

NITRIFICATION/DISTRIBUTION AND DRAINFIELD INSPECTION

DISTRIBUTION BOX		
Level <u>✓</u>	_____	_____
Equal Distribution <u>✓</u>	_____	_____
Other _____	_____	_____

DISTRIBUTION MANIFOLD		
Pipe Size _____	_____	_____
Gate Valves _____	_____	_____
Other _____	_____	_____

OTHER DISTRIBUTION
Type _____

NITRIFICATION LINES	LINE 1	LINE 2	LINE 3	LINE 4	LINE 5	LINE 6
Trench Width	<u>3</u>	<u>3</u>	<u>3</u>	_____	_____	_____
Trench Length	<u>133</u>	<u>130</u>	<u>133</u>	_____	_____	_____
Trench Grade	<u>✓</u>	<u>✓</u>	<u>✓</u>	_____	_____	_____
Stone Depth	<u>accept poly styrene</u>	<u>accept poly styrene</u>	<u>accept poly styrene</u>	_____	_____	_____

WELL INSPECTION

LOCATION OF WELL _____

COMMENTS: _____

Granville – Vance District Health Department
Environmental Health

Final Sketch

Pin _____

____ Improvement Permit

____ Construction Authorization

Wynn Coats
Applicant's Name

Permit No. 8750


Chesleigh 127
Subdivision – Section – Lot

Physical Address: _____

Blockley Bros
System Installer

11/14/2016
Date

System design and details as installed.

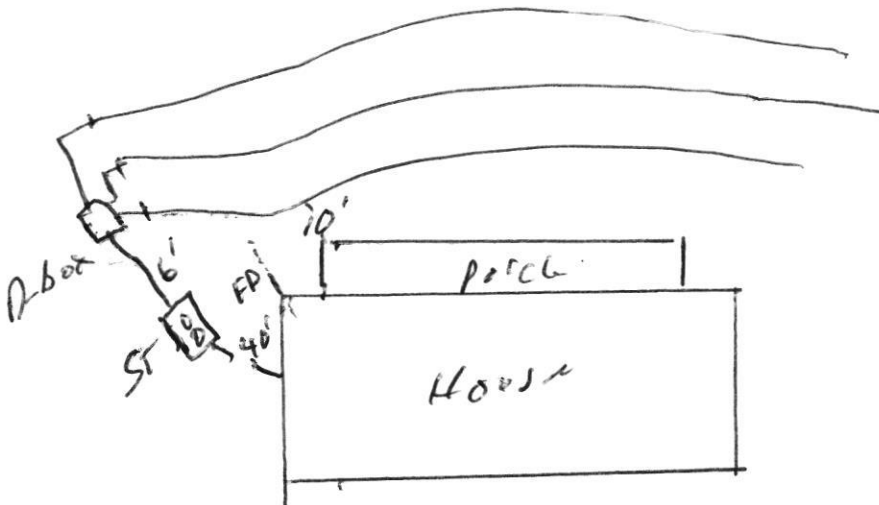

Butterfly

Walter T. Van L...
Authorized Signature

11/14/16
Date

Submit the original to the Division of Water Quality within 30 days. Attn: Information Mgt., 1617 Mail Service Center - Raleigh, NC 27699-1617 Phone No. (919) 733-7015 ext 568.

1. WELL CONTRACTOR: Van Elliott
Well Contractor (Individual) Name
SOUTHERN WELL DRILLING
Well Contractor Company Name
STREET ADDRESS 1530 Beaver Dam Road
Creedmoor NC 27522
City or Town State Zip Code
Area code - Phone number (919) 603-7165

2. WELL INFORMATION: SITE WELL ID # (if applicable) 1917
STATE WELL PERMIT # (if applicable)
DWG or OTHER PERMIT # (if applicable)
WELL USE (Check Applicable Box): Residential Water Supply ☐
DATE DRILLED 1-17-17
TIME COMPLETED
AM ☐ PM ☐

3. WELL LOCATION: CITY: Creedmoor COUNTY: Granville
Chas. R. 54 Lot 1A7
(Street Name, Numbers, Community, Subdivision, Lot No., Parcel, Zip Code)

TOPOGRAPHIC / LAND SETTING:
☐ Slope ☐ Valley ☒ Flat ☐ Ridge ☐ Other
(check appropriate box)

Latitude Longitude
LATITUDE 3
LONGITUDE
May be in degrees, minutes, seconds or in a decimal format

4. WELL OWNER OWNER'S NAME Wagon Const
STREET ADDRESS
Creedmoor
City or Town State Zip Code
Area code - Phone number

5. WELL DETAILS: a. TOTAL DEPTH: 300
b. DOES WELL REPLACE EXISTING WELL? YES ☐ NO ☒
c. WATER LEVEL Below Top of Casing: 20 FT.
(Use "+" if Above Top of Casing)
d. TOP OF CASING IS 1 FT. Above Land Surface
Top of casing terminated at/ or below land surface may require a variance in accordance with 15A NCAC 2C .0118.
e. YIELD (gpm): 5 METHOD OF TEST Air



RESIDENTIAL WELL CONSTRUCTION RECORD

North Carolina Department of Environment and Natural Resources – Division of Water Quality

WELL CONTRACTOR CERTIFICATION # 3104