


NOTE: Make sketch of installation showing location of house, septic tanks, privies, water supplies on adjacent property, etc. Write in measurements in order that installations may be located at later date.

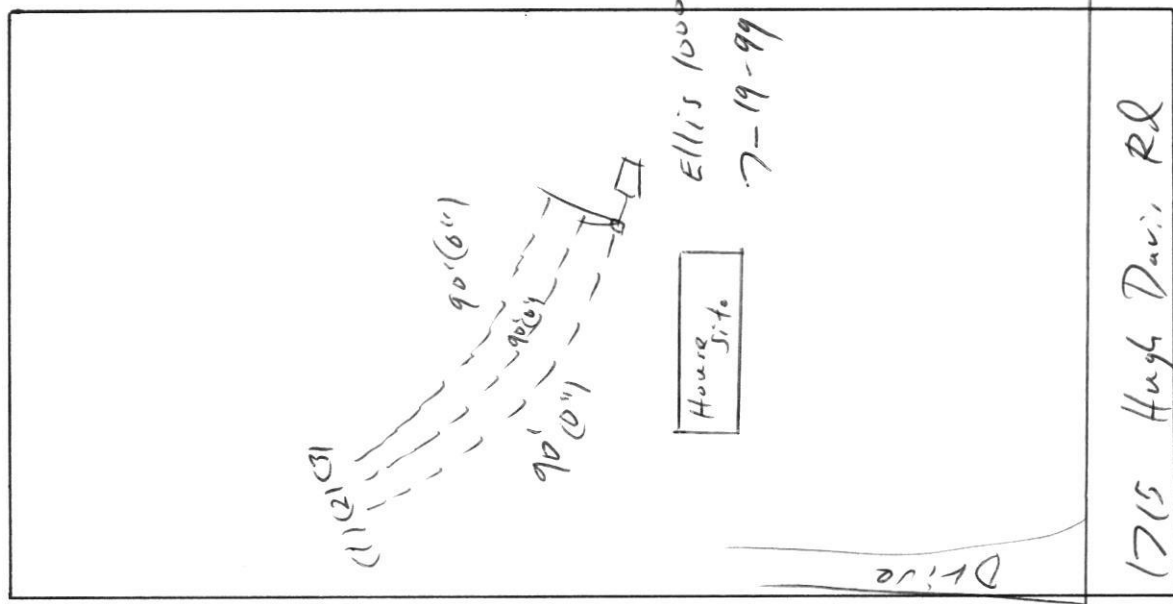

Ellis 1000
7-19-99

S.R. 1715 Hugh Davis Rd

Woodland Chapel Rd.

GRANVILLE-VANCE HEALTH DEPARTMENT—Sewage Disposal Record

Owner or Contractor H. R. Hoffman Date 9-3-99 S.R. No. 1715

Location/Address 4070 Hugh Davis Rd

Subdivision/Mobile Home Park Name _____ Lot Size _____

Permit No. # 2075 Lot No. _____

New System _____ Repair ☒

House _____ Mobile Home SW Business _____

No. Bedrooms 2 No. People 2 No. Toilets _____

Water Supply: Private ☒ Approved _____

Semi-Public _____ Unapproved _____

Public _____ None _____

Nitrification System: _____

Tank Size 1000 gal.

Distribution Box ☒ No. Lines 3

Nitrification Field 800 Sq. Ft.

Lines: 3' 2' 3' 4 5 6

Width 3' 3' 3' _____

Length 90' 90' 90' _____

Grade 0" 0" 0" _____

Stone Depth 12" 12" 12" _____

Layout to be followed by installer:

Improvements Permit By Eddie Yount Installer Cole's Backhoe Service

Certificate of Completion By Eddie Yount Date of Inspection 9-3-99

* Construction must comply with all other applicable state and local regulations, but the permit is not a guarantee that the system will not malfunction and the Granville-Vance Health District will not be held responsible for a malfunctioning system.