


NOTE: Make sketch of installation showing location of house, septic tanks, privies, water supplies on adjacent property, etc. Write in measurements in order that installations may be located at later date.

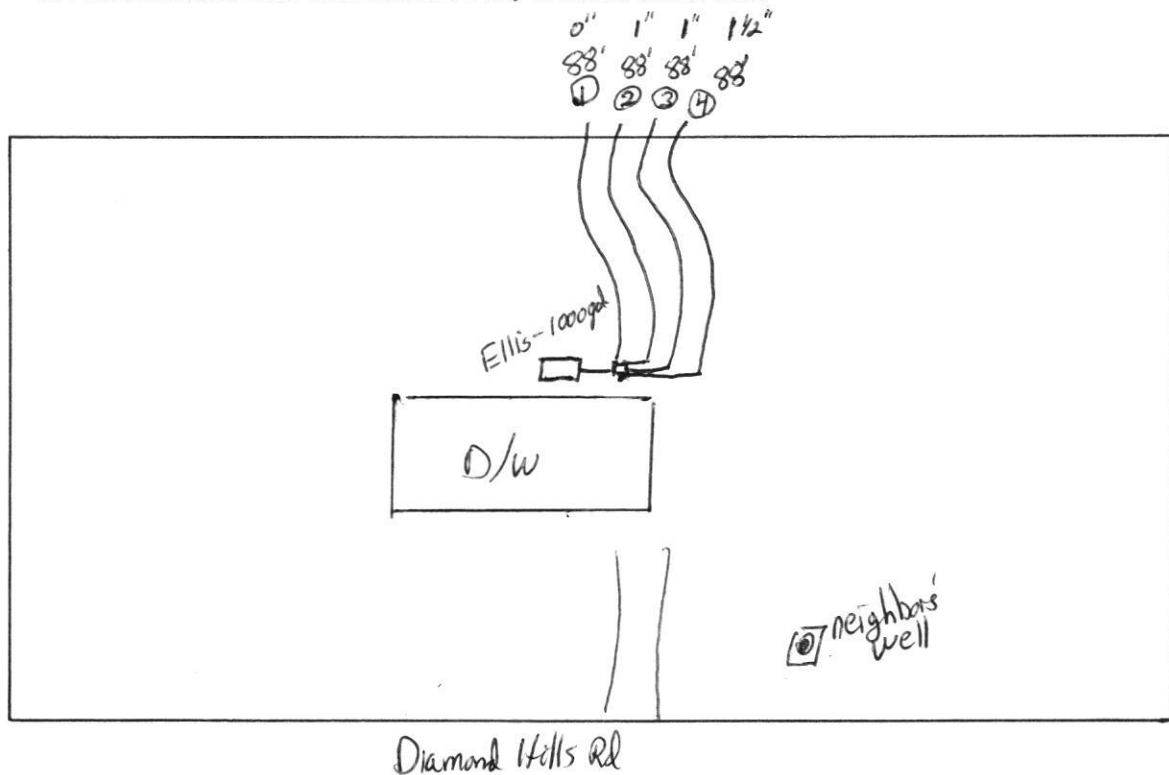

GRANVILLE-VANCE HEALTH DEPARTMENT—Sewage Disposal Record

Owner or Contractor Louisburg Development Date 4-22-00 S.R. No. 1138
 Location/Address Culbreth Rd.
 Subdivision/Mobile Home Park Name Cedar Hills Lot Size _____
 Permit No. # 2441 Lot No. 3

New System Repair
 House _____ Mobile Home _____ Business _____
 No. Bedrooms 3 No. People _____ No. Toilets _____
 Water Supply: Private ✓ Approved _____
 Semi-Public _____ Unapproved _____
 Public _____ None _____

Nitrification System:

Tank Size 1000 gal.
 Distribution Box yes No. Lines 4
 Nitrification Field 1050 Sq. Ft.
 Lines: 1 2 3 4 5 6
 Width 3' 3' 3' 3' _____
 Length 88' 88' 88' 88' _____
 Grade 0" 1" 1" 1½" _____
 Stone Depth 12" 12" 12" 12" _____

Layout to be followed by installer:

* sketch on back

Improvements Permit By Paul Gower M.E.Y. Installer Blackley Bros.
 Certificate of Completion By David Cumba Date of Inspection 7-17-02

* Construction must comply with all other applicable state and local regulations, but the permit is not a guarantee that the system will not malfunction and the Granville-Vance Health District will not be held responsible for a malfunctioning system.