


NOTE: Make sketch of installation showing location of house, septic tanks, privies, water supplies on adjacent property, etc. Write in measurements in order that installations may be located at later date.

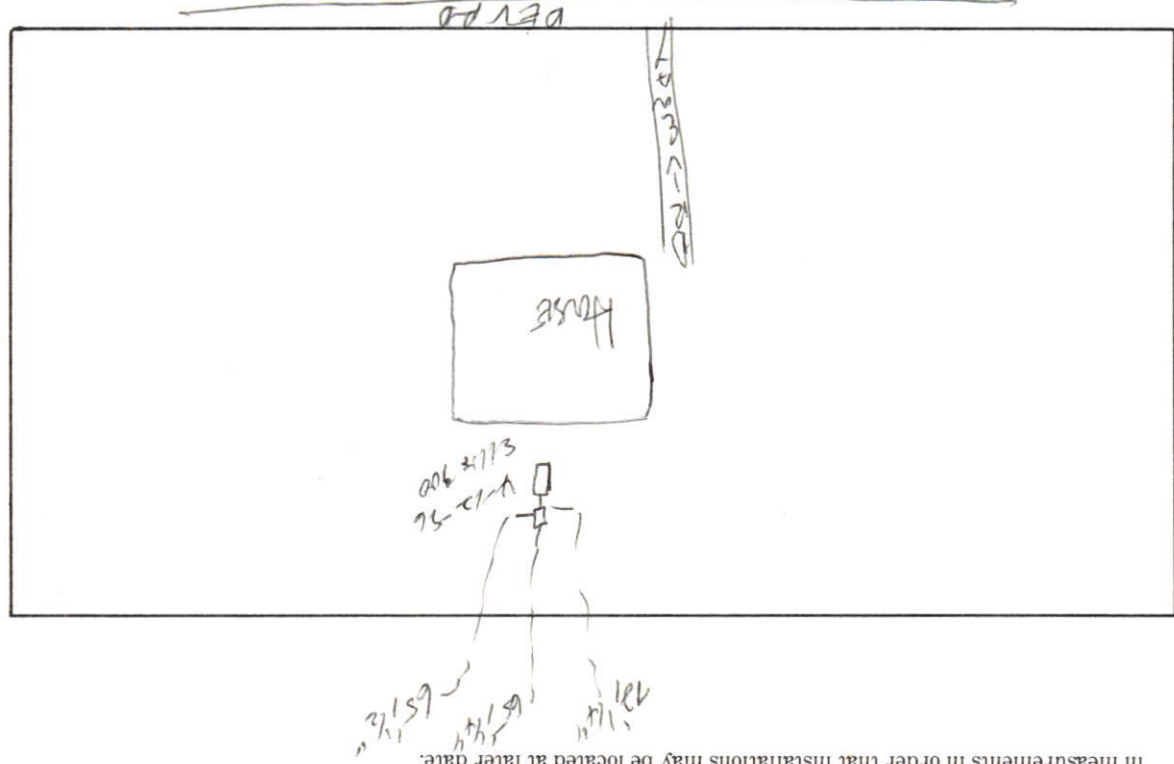

GRANVILLE-VANCE HEALTH DEPARTMENT—Sewage Disposal Record

Owner or Contractor Harold Mitchell Date 3-25-96 S.R. No. NC965

Location/Address NC 965 - Franklin, NC

Subdivision/Mobile Home Park Name Mitchell Acres Lot Size 9 EA

Permit No. # 035 Lot No. 5

New System ☒ Repair ☐

House ☒ Mobile Home ☐ Business ☐

No. Bedrooms 3 No. People FS No. Toilets ☐

Water Supply: Private ☒ Approved ☐

Semi-Public ☐ Unapproved ☐

Public ☐ None ☐

Nitrification System:

Tank Size 900 gal.

Distribution Box ☒ No. Lines 3

Nitrification Field 900 Sq. Ft.

Lines:	1	2	3	4	5	6
Width	<u>3'</u>	<u>3'</u>	<u>3'</u>			
Length	<u>72'</u>	<u>65'</u>	<u>65'</u>			
Grade	<u>1/4"</u>	<u>1/4"</u>	<u>1/2"</u>			
Stone Depth	<u>18"</u>	<u>18"</u>	<u>18"</u>			

Layout to be followed by installer:

Improvements Permit By Charly E. Noble Installer Backley Brothers

Certificate of Completion By Cheri Hedrick Date of Inspection 5-31-96

* Construction must comply with all other applicable state and local regulations, but the permit is not a guarantee that the system will not malfunction and the Granville-Vance Health District will not be held responsible for a malfunctioning system.